

# Annex Q

## NORM Survey Report





**JABARRA**  
RADIOPROTEÇÃO

## **NORM Survey Report**

**FPSO Fluminense**

**JAB-REL-SHE-FLU-007**

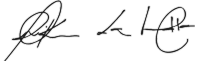

Prepared by:	Eriksen Matta	Signature:	
Approved by:	Eduardo André	Signature:	
Revision:	0	Date:	05/22/2023
<p>Jabarra Serviços de Radioproteção LTDA ME Avenida Silvio Picanço 463, sala 404 – Charitas, Niterói, Rio de Janeiro contato@jabarra.com.br / (21) 2510-4828 / (21) 2510-4827 www.jabarra.com.br</p>			

This document is property of Jabarra Radioproteção, therefore, copying and/or disclosing the information contained in this document is prohibited without permission. This document has been reviewed and approved following the management system standard. The most recent version is considered a controlled copy and all other copies are considerate for reference only. It is the owner's responsibility to ensure that the latest approved version has been considered. © **JABARRA RADIOPROTEÇÃO**

JAB-REL-SHE-FLU-007	<b>JABARRA RADIOPROTEÇÃO LTDA</b>	Date: 05/22/2023
Revision: 0	<b>NORM Survey Report</b>	Page: 2 of 20

## Revision Record

Revision	Date	Description
0	05/22/2023	First Issue

JAB-REL-SHE-FLU-007	<b>JABARRA RADIOPROTEÇÃO LTDA</b>	Date: 05/22/2023
Revision: 0	<b>NORM Survey Report</b>	Page: 3 of 20

## Index

1. Introduction .....	4
2. Description of the Field.....	5
3. Objective .....	5
4. References.....	5
5. Equipment.....	6
6. Radiometric Survey .....	6
6.1. Equipment Checklist.....	6
6.2. Radiation Meter Operation Test .....	7
6.3. Radiometric Survey on Equipment .....	7
7. Results .....	8
8. Conclusion .....	12
ANNEX A – Radiation Meter Calibration Certificate .....	14
ANNEX B – Radiation Meter Operation Test.....	18
ANNEX C – Marked P&IDs .....	20



JAB-REL-SHE-FLU-007	<b>JABARRA RADIOPROTEÇÃO LTDA</b>	Date: 05/22/2023
Revision: 0	<b>NORM Survey Report</b>	Page: 4 of 20

## 1. Introduction

NORM is an acronym formed by the first letters of the expression "Naturally Occurring Radioactive Material". This type of material might be found in certain oil production sites and a comprehensive procedure is required to properly identify, manage, transfer and treat these materials.

The presence of radionuclides from natural series of Uranium and Thorium are common in oil and gas exploration and production. The main characteristics of this occurrence are:

- There are usually no gamma equivalent dose rates with high values;
- Limited number of nuclides (mainly U and Th disintegration chains);
- Chains of long disintegration - long periods of decay;
- Inhalation and ingestion are the main concerns from the dose point of view.

The deposition of Radium ( $^{228}\text{Ra}$ ,  $^{226}\text{Ra}$ ,  $^{224}\text{Ra}$ ) occurs because of the  $\alpha$ -decay from their immediate parent ( $^{228}\text{Th}$ ,  $^{230}\text{Th}$ ,  $^{232}\text{Th}$ ). In addition, Ra prefers the aqueous phase, leading to enhanced concentrations. Therefore, after production, the Ra will follow the aqueous produced water stream. Radium is chemically similar to barium (Ba), strontium (Sr), calcium (Ca) and magnesium (Mg), and it becomes incorporated into sulfate or carbonate deposition. Once deposited inside equipment or produced at the surface, all three Ra show different behavior.

- $^{228}\text{Ra}$  reaches secular balance with  $^{228}\text{Ac}$  very quickly (within two days).

However, in a much slower process (about 10 years),  $^{228}\text{Th}$ , that was absent in deposits of produced water, grows in (transient balance). With the arising of  $^{228}\text{Th}$  all NORMs chain until  $^{208}\text{Pb}$  appear in about two weeks.

- $^{226}\text{Ra}$  starts a secular balance (within two weeks) of short-lived NORMs ( $^{222}\text{Rn}$ ,  $^{218}\text{Po}$ ,  $^{214}\text{Pb}$ ,  $^{214}\text{Bi}$  and  $^{214}\text{Po}$ ) of its own. The growth of  $^{210}\text{Pb}$  occurs in a much slower rate (about 100 years).
- $^{224}\text{Ra}$  appears in produced water or its deposits without its immediate parent  $^{228}\text{Th}$ . That is why its concentration does not grow. It actually tends to disappear (within two weeks). This implies that only in samples of fresh produced water  $^{224}\text{Ra}$  may be detected. With the reappearance of  $^{228}\text{Th}$ ,  $^{224}\text{Ra}$  will also reappear in more aged samples.

Radon (Rn) isotopes are noble gas elements and prefer the (natural) gas phase for transport to



JAB-REL-SHE-FLU-007	<b>JABARRA RADIOPROTEÇÃO LTDA</b>	Date: 05/22/2023
Revision: 0	<b>NORM Survey Report</b>	Page: 5 of 20

the surface. As  $^{220}\text{Rn}$  only lives for a few minutes, by the time that this element reaches the surface, it will have decayed.  $^{222}\text{Rn}$  with a half-life of about four days may appear in Liquid Natural Gas (LNG) processing installations, in the upper part of the crude oil storage tanks or in Natural Gas (NG) transmission lines. Ultimately, it will decay to  $^{210}\text{Pb}$ , but as  $^{222}\text{Rn}$  owns a short-life compared to  $^{210}\text{Pb}$ , no balance status will be reached.

In gas or oil fields, where stable Pb is present in produced waters,  $^{210}\text{Pb}$  may be incorporated in any formed deposit as well. In this kind of deposit,  $^{210}\text{Pb}$  activity concentrations will be higher than  $^{226}\text{Ra}$  activity concentration, indicating that an independent mechanism for Pb transport is present.

The level of NORM accumulation can vary substantially from one facility to another, depending on geological formation and operational conditions, and will also change over the lifetime of a well. NORM cannot be differentiated immediately from other oilfield wastes, except by specific measurement. The quantity of material does not necessarily define the amount of NORM present or the radiological risk that it may represent. To determine whether or not a facility is accumulating NORM, a periodic NORM survey with subsequent sampling and analysis needs to be conducted.

## 2. Description of the Field

The FPSO FLUMINENSE, operated by MODEC, is located in the Bijupirá and Salema fields. The Bijupirá and Salema fields, discovered in 2003, are located on the North Fluminense coast, approximately 295 kilometers from the city of Rio de Janeiro, located in the Campos Basin, with a water depth of around 400-870 meters.

## 3. Objective

This document presents the results of a radiometric survey carried out on board of FPSO Fluminense operated by SHELL. The work scope included a complete radiometric survey of the oil production and water separation plant, followed by the interpretation of the results.

## 4. References

**NORMA CNEN NN - 3.01**



JAB-REL-SHE-FLU-007	<b>JABARRA RADIOPROTEÇÃO LTDA</b>	Date: 05/22/2023
Revision: 0	<b>NORM Survey Report</b>	Page: 6 of 20

Diretrizes Básicas de Proteção Radiológica

**NORMA CNEN NE - 3.02**

Serviços de Radioproteção

**NORMA CNEN NN - 8.01**

Gerência de Rejeitos Radioativos de Baixos e Médios Níveis de Radiação

**Lei Nº 10.308, de 20 de Novembro de 2001.**

**NR-37 – Segurança e Saúde em Plataformas de Petróleo**

**IOGP - Managing Naturally Occurring Radioactive Material (NORM) in the oil and gas industry – Report 412 – March/2016**

**Diretrizes para gerenciamento de materiais radioativos de ocorrência natural (NORM) / Instituto Brasileiro de Petróleo, Gás e Biocombustíveis. – Rio de Janeiro: IBP, 2019.**

**Plano de Proteção Radiológica - FPSO Fluminense - Revisão 02 de 24/10/2022.**

**Plano de Gerenciamento de Resíduos NORM - FPSO Fluminense - Revisão 03 de 21/03/2023.**

## **5. Equipment**

In order to carry out this radiometric survey for NORM presence, on the oil production and water separation plant, it was used a Scintillator radiation meter (model: Ludlum 3001), which is capable of distinguish the different radiations and energy that are emitted from the homogeneous material.

The annual Calibration Certificate and equipment data can be found in Annex B of this Report.

## **6. Radiometric Survey**

In this part of the procedure, the process involved in the monitoring task of the oil production and water separation plant will be presented.

### **6.1. Equipment Checklist**



JAB-REL-SHE-FLU-007	<b>JABARRA RADIOPROTEÇÃO LTDA</b>	Date: 05/22/2023
Revision: 0	<b>NORM Survey Report</b>	Page: 7 of 20

Before carrying out the work, it is necessary to make a checklist of all the devices to be used in the following tasks:

- Radiation meter;
- Test source for admeasuring the radiation meter;
- Forms.

## **6.2. Radiation Meter Operation Test**

The test of the radiation meter relays on the following steps:

- 1) Check if the radiation meter battery is charged and the calibration certificate is updated.
- 2) Choose the monitoring mode in terms of reading speed (slow / fast) and select the scale to be used (x0.1; x1.0; x10; x100).
- 3) Using the test source, “read” it in the standard condition to determine the standard value. This standardization procedure should be performed only once, right after the calibration of the radiation meter. The measurement of the standard condition should be made by touching the radiation meter against the open test source, making 3 (three) measurements and averaging them.
- 4) Standard condition is the measurement made at a given distance and position from the detector in relation to the test source during the reading time.
- 5) Standard value is the measure of the exposure rate or equivalent dose rate in the standard condition and should be used as a reference value for comparing the next measurements,
- 6) Using the test source, perform the reading process in the standard condition;
- 7) Compare the reading performed with the standard value, if the deviation found is equal to or less than 20% of the standard value, the equipment (radiation meter) is suitable for use. Otherwise, the radiation meter must be sent for maintenance and new calibration, as it is outside the acceptance range;
- 8) Record the reading as well as the data related to the equipment (radiation meter) on the function/operation test form.

## **6.3. Radiometric Survey on Equipment**

The radiometric survey of the equipment demonstrated in item 6 of this Monitoring Report must follow the general steps described below:

JAB-REL-SHE-FLU-007	<b>JABARRA RADIOPROTEÇÃO LTDA</b>	Date: 05/22/2023
Revision: 0	<b>NORM Survey Report</b>	Page: 8 of 20

- 1) Check if the radiation meter battery is charged and the calibration certificate is updated.
- 2) Choose an appropriate scale, taking into account that the values read correspond to the chosen scale.
- 3) Perform the Radiation Meter test, using the Cs-137 test source.
- 4) Check if the deviation between the measured value and the standard value is within the range ( $\pm 20\%$ ).
- 5) Perform the background radiation measurement, approximately 2 (two) meters from the equipment. At this stage, it is necessary to ensure that, when measuring the bottom, there is no other radiation source that affects the monitoring result.
- 6) Take the respective readings along the entire length of the equipment / line, filling out the form provided.
- 7) Archive the measured readings in standard report format.

## 7. Results

The radiometric survey was performed on 3rd May, 2023. The table below presents the maximum values found for equivalent dose rate in each of the equipment/lines.

**Table 1 - Results of monitoring carried out at the production plant**

TAG	Equipment	Local	PI&D	05/03/2023		
				Radiation meter equipment: Ludlum 3001 (Scintillator)		
				Surface ( $\mu\text{Sv/h}$ )	1 meter ( $\mu\text{Sv/h}$ )	Background ( $\mu\text{Sv/h}$ )
HBG-1050	Salema Inlet Heater	Module 1	20-0103	0,07	0,07	0,07
16"-PF-B1-1001	Inlet	HBG-1050 Inlet	20-0103	0,67	0,10	0,07
2"DC-A-5009	Closed Drain	HBG-1050	20-0103	0,07	0,07	0,07
16"PF-A-1007	Outlet	from HBG-1050 to MBD-1010	20-0103	0,07	0,07	0,07
MBD-1010	Salema Production Separator	Module 1	20-0103	0,07	0,07	0,07
16"PF-A-1007	Inlet	from HBG-1050	20-0103	0,07	0,07	0,07
2"PW-A-2003	PW Inlet	from MBM-3610 to MBD-1010	20-0103	0,07	0,07	0,07
3"PW-A-2003	PW Inlet	from MBM-3610 to MBD-1010	20-0103	0,07	0,07	0,07
4"DC-A-5001	Closed Drain	MBD-1010	20-0103	0,47	0,08	0,07
4"DC-A-5002	Closed Drain	MBD-1010	20-0103	0,07	0,07	0,07
HBG-1055	Bijupirá Inlet Heater	Module 1	20-0104	0,26	0,16	0,07



JAB-REL-SHE-FLU-007	<b>JABARRA RADIOPROTEÇÃO LTDA</b>	Date: 05/22/2023
Revision: 0	<b>NORM Survey Report</b>	Page: 9 of 20

TAG	Equipment	Local	PI&D	05/03/2023		
				Radiation meter equipment: Ludlum 3001 (Scintillator)		
				Surface ( $\mu\text{Sv/h}$ )	1 meter ( $\mu\text{Sv/h}$ )	Background ( $\mu\text{Sv/h}$ )
16"-PF-B1-1000	Inlet	HBG-1055 Inlet	20-0104	0,58	0,12	0,07
2"DC-A-5010	Closed Drain	HBG-1055 Inlet	20-0104	0,10	0,07	0,07
16"PF-A-1009	Outlet	from HBG-1055 to MBD-1015	20-0104	0,62	0,14	0,07
MBD-1015	Bijupirá Production Separator	Module 1	20-0104	0,09	0,07	0,07
16"PF-A-1009	Inlet	from HBG-1055	20-0104	0,51	0,09	0,07
2"PW-A-2007	PW Inlet	from MBM-3610 to MBD-1015	20-0104	0,07	0,07	0,07
3"PW-A-2007	PW Inlet	from MBM-3610 to MBD-1015	20-0104	0,19	0,08	0,07
4"DC-A-5004	Closed Drain	MBD-1015	20-0104	0,84	0,07	0,07
4"DC-A-5005	Closed Drain	MBD-1015	20-0104	0,07	0,07	0,07
8"PW-A-2004	PW Outlet	from MBM-1015 to MBD-3610	20-0104	0,59	0,11	0,07
HBG-1060	Test Inlet Heater	Module 1	20-0105	0,07	0,07	0,07
10"-PF-B1-1002	Inlet	HBG-1060 Inlet	20-0105	0,14	0,07	0,07
2"DC-A-5011	Closed Drain	HBG-1060 Inlet	20-0105	0,08	0,07	0,07
10"PF-A-1011	Outlet	from HBG-1060 to MBD-1020	20-0105	0,07	0,07	0,07
MBD-1020	Test Production Separator	Module 1	20-0105	0,10	0,07	0,07
10"PF-A-1011	Inlet	from HBG-1060	20-0105	0,07	0,07	0,07
2"PW-A-2011	PW Inlet	from MBM-3610 to MBD-1020	20-0105	0,07	0,07	0,07
3"PW-A-2011	PW Inlet	from MBM-3610 to MBD-1020	20-0105	0,07	0,07	0,07
4"DC-A-5007	Closed Drain	MBD-1020	20-0105	0,50	0,08	0,07
4"DC-A-5008	Closed Drain	MBD-1020	20-0105	0,07	0,07	0,07
4"PW-A-2008	PW Outlet	from MBM-1020 to MBD-3610	20-0105	0,77	0,09	0,07
MBM-3610	Water Collection / Skim Vessel	Module 1/2	20-0121	0,11	0,07	0,07
8"PW-A-2004	Inlet	From Separators	20-0121	1,04	0,13	0,07
4"PW-A-2008	Inlet	From Test Separator	20-0121	0,42	0,11	0,07
6"PW-A-2023	Bypass	From Separators	20-0121	0,40	0,12	0,07
8"PW-A-2025	Outlet	From MBM-3610 to ZBM-3620	20-0121	0,65	0,13	0,07
3"PW-A-2003	Sand Jet Line	From MBM-3610 to MBD-1010	20-0121	0,10	0,07	0,07
2"DC-A-5075	Closed Drain	MBM-3610	20-0121	0,09	0,07	0,07
2"PW-A-2013	Outlet	From MBM-3610 to HBG-1110	20-0121	0,23	0,07	0,07
2"DC-A-5060	Closed Drain	From MBM-3610	20-0121	0,23	0,07	0,07
ZBM-3620	Hydrocyclone	Module 2	20-0122	0,46	0,13	0,07
8"PW-A-2044	Inlet	From MBM-3610	20-0122	0,20	0,07	0,07



JAB-REL-SHE-FLU-007	<b>JABARRA RADIOPROTEÇÃO LTDA</b>	Date: 05/22/2023
Revision: 0	<b>NORM Survey Report</b>	Page: 10 of 20

TAG	Equipment	Local	PI&D	05/03/2023		
				Radiation meter equipment: Ludlum 3001 (Scintillator)		
				Surface ( $\mu\text{Sv/h}$ )	1 meter ( $\mu\text{Sv/h}$ )	Background ( $\mu\text{Sv/h}$ )
8"PW-A-2045	Bypass	Bypass	20-0122	0,22	0,07	0,07
8"PW-A-2047	Outlet	from ZBM-3620 to MBM-3630	20-0122	0,97	0,17	0,07
2"PW-A-2046	Outlet	to 2"DC-A	20-0122	0,10	0,07	0,07
PDI-1110-1	Basket Strainer	Module 2	20-0106	0,59	0,11	0,07
12"PL-A-1112	Inlet	from BGC first stage	20-0106	0,42	0,09	0,07
8"PL-A-1113	Inlet	from Basket Strainer to HBG-1110A	20-0106	0,59	0,11	0,07
HBG-1110A	Crude/Crude Exchanger	Module 2	20-0106	0,26	0,16	0,07
HBG-1110B	Crude /Crude Exchanger	Module 2	20-0106	0,52	0,21	0,07
HBG-1115	Crude Heater	Module 2	20-0106	0,14	0,12	0,07
MBD-1125	IP Separator	Module 2/3	20-0107	0,10	0,07	0,07
2"PL-A-1188	Outlet	Offspec tanks	20-0107	0,23	0,13	0,07
4"DC-A-5024	Closed Drain	MBD-1125	20-0107	0,24	0,08	0,07
4"PW-A-2044	Outlet	to 3"PW-A-2045	20-0107	0,24	0,09	0,07
3"PW-A-2045	Outlet	to MBM-3610	20-0107	0,29	0,12	0,07
KJA-1125	IP separator pumps filter	-	20-0107	0,10	0,07	0,07
PBA-1125A	Produced water drain pumps	-	20-0107	0,12	0,07	0,07
PBA-1125B	Produced water drain pumps	-	20-0107	0,09	0,07	0,07
ZBM-3630	Flotation Cell	Module 2	20-0123	0,07	0,07	0,07
8"PW-A-2047	Inlet	from ZBM-3620 to MBM-3630	20-0123	1,26	0,07	0,07
8"PW-A-2037	Outlet	from MBM-3630 to HBG-3650	20-0123	1,15	0,23	0,07
4"DC-A-5050	Closed Drain	MBM-3630	20-0123	0,56	0,12	0,07
4"DC-A-5049	Closed Drain	MBM-3630	20-0123	0,23	0,12	0,07
PBA-3550A	Flotation Cell Pump	Module 2	20-0123	0,14	0,07	0,07
6"PL-A	Inlet	Circulation	20-0123	0,21	0,13	0,07
4"PL-A	Outlet	Circulation	20-0123	0,43	0,12	0,07
PBA-3550B	Flotation Cell Pump	Module 2	20-0123	0,17	0,07	0,07
6"PL-A	Inlet	Circulation	20-0123	0,21	0,13	0,07
4"PL-A	Outlet	Circulation	20-0123	0,46	0,12	0,07
HBG-3650	Produced Water Cooler	Module 2	20-0123	0,38	0,22	0,07
8"PW-A-2043	Inlet	from MBM-3630 to HBG-3650	20-0123	0,30	0,25	0,07
10"PW-A-2033	Outlet	Water Overboard	20-0123	0,61	0,14	0,07
8"PW-A-2099	Bypass	Bypass	20-0123	0,44	0,14	0,07



JAB-REL-SHE-FLU-007	<b>JABARRA RADIOPROTEÇÃO LTDA</b>	Date: 05/22/2023
Revision: 0	<b>NORM Survey Report</b>	Page: 11 of 20

TAG	Equipment	Local	PI&D	05/03/2023		
				Radiation meter equipment: Ludlum 3001 (Scintillator)		
				Surface ( $\mu\text{Sv/h}$ )	1 meter ( $\mu\text{Sv/h}$ )	Background ( $\mu\text{Sv/h}$ )
MBK-1140A	Electrostatic Treater	Module 3	20-0108	0,07	0,07	0,07
10"PL-A-1141	Inlet	from MBD-1125	20-0108	0,16	0,07	0,07
10"PL-A-1129	Outlet	to Crude Exchangers	20-0108	0,07	0,07	0,07
3"PL-A-1189	Outlet	to Offspec Tanks	20-0108	0,07	0,07	0,07
3"PW-A-2014	Outlet	to Oil Treater Water Pumps	20-0108	0,44	0,07	0,07
6"PG-A-1215	Outlet	to FGC first stage	20-0108	0,07	0,07	0,07
4"DC-A-5026	Closed Drain	MBK-1140A	20-0108	0,38	0,07	0,07
MBK-1140B	Electrostatic Treater	Module 3	20-0109	0,07	0,07	0,07
10"PL-A-1142	Inlet	from MBD-1125	20-0109	0,33	0,07	0,07
10"PL-A-1132	Outlet	to Crude Exchangers	20-0109	0,07	0,07	0,07
4"DC-A-5032	Closed Drain	MBK-1140B	20-0109	0,16	0,07	0,07
3"PW-A-2015	Outlet	to Oil Treater Water Pumps	20-0109	0,36	0,07	0,07
2"PL-A-1192	Outlet	to Offspec Tanks	20-0109	0,07	0,07	0,07
6"PG-A-1218	Outlet	to 8"PG-A-1215	20-0109	0,07	0,07	0,07
8"PG-A-1215	Outlet	to FGC first stage	20-0109	0,07	0,07	0,07
PBA-1145A	Oil Treater Water Pump	Module 3	20-0108	0,07	0,07	0,07
3"PW-A-2014	Inlet	from Electrostatic Treater	20-0108	0,07	0,07	0,07
2"PW-A-2012	Outlet	to Crude / Crude Exchanger	20-0108	0,07	0,07	0,07
1"DC-A-5030	Closed Drain	PBA-1145A	20-0108	0,07	0,07	0,07
PBA-1145B	Oil Treater Water Pump	Module 3	20-0108	0,07	0,07	0,07
3"PW-A-2015	Inlet	from Electrostatic Treater	20-0108	0,08	0,07	0,07
2"PW-A-2018	Outlet	to Crude / Crude Exchanger	20-0108	0,07	0,07	0,07
1"DC-A-5029	Closed Drain	PBA-1145B	20-0108	0,10	0,07	0,07
PBA-1145C	Oil Treater Water Pump	Module 3	20-0108	0,07	0,07	0,07
3"PW-A-2016	Inlet	from Electrostatic Treater	20-0108	0,11	0,07	0,07
2"PW-A-2017	Outlet	to Crude / Crude Exchanger	20-0108	0,07	0,07	0,07
1"DC-A-5028	Closed Drain	PBA-1145C	20-0108	0,07	0,07	0,07
2"PW-A-2019	Outlet	to Crude / Crude Exchanger	20-0108	0,07	0,07	0,07
ABH-3410	Closed Drain Sump Tank	Module 10	20-0124	0,28	0,07	0,07
6"DC-D-5051	Inlet	from Closed Drains	20-0124	0,10	0,07	0,07
3"PW-A-2035	Inlet	from MBM-3610	20-0124	0,07	0,07	0,07
6"PL-A-1160	Outlet	to Closed Drain Sump Pumps	20-0124	0,27	0,07	0,07



JAB-REL-SHE-FLU-007	<b>JABARRA RADIOPROTEÇÃO LTDA</b>	Date: 05/22/2023
Revision: 0	<b>NORM Survey Report</b>	Page: 12 of 20

TAG	Equipment	Local	PI&D	05/03/2023		
				Radiation meter equipment: Ludlum 3001 (Scintillator)		
				Surface ( $\mu\text{Sv/h}$ )	1 meter ( $\mu\text{Sv/h}$ )	Background ( $\mu\text{Sv/h}$ )
PBE-3415A	Oil Treater Water Pump	Module 3	20-0124	0,07	0,07	0,07
4"PL-A-1161	Inlet	from ABH-3410	20-0124	0,22	0,07	0,07
3"PL-A-1162	Outlet	to MBM-3610	20-0124	0,15	0,07	0,07
4"PL-A-1154	Outlet	to MBM-3610	20-0124	0,15	0,07	0,07
4"PL-A-1164	Outlet	to Crude / Crude Exchanger	20-0124	0,07	0,07	0,07
PBE-3415B	Oil Treater Water Pump	Module 3	20-0124	0,07	0,07	0,07
4"PL-A-1160	Inlet	from ABH-3410	20-0124	0,38	0,07	0,07
3"PL-A-1154	Outlet	to MBM-3610	20-0124	0,09	0,07	0,07
4"PL-A-1154	Outlet	to MBM-3610	20-0124	0,15	0,07	0,07
4"PL-A-1164	Outlet	to Crude / Crude Exchanger	20-0124	0,07	0,07	0,07
PBE-1210	Flowline Circulation Pump	Module 2	20-0147	0,07	0,07	0,07
10"PL-A-1143	Inlet	from MBD-1125	20-0147	0,07	0,07	0,07
8"PL-B-1100	Outlet	to Incoming Test Line	20-0147	0,07	0,07	0,07

## 8. Conclusion

In 2007, the International Commission on Radiological Protection (ICRP) recommended a public dose (risk) limit of 1 mSv/y additional to the natural background dose (~2.4 mSv/year). Ordinary gas and oil industry workers are treated as a member of the public with a limited exposure time (2,000 h/year). These recommendations have been implemented in the International Atomic Energy Agency (IAEA) Basic Safety Standards (BSS).

Taking in consideration that the Radiometric Survey is the first step to confirm the presence of NORM, for this specific scope of work, any results that does not meet with the established criteria should indicate the presence of NORM on the area/surface/equipment in question.

Section 7 of this report presents the results of the Radiometric Survey for all equipment selected by offshore and onshore workers. Therefore, considering the measurements performed, as well as the unit's history, several devices had an equivalent dose rate considerably higher than the background radiation level (background), which indicates the presence of NORM inside.



JAB-REL-SHE-FLU-007	<b>JABARRA RADIOPROTEÇÃO LTDA</b>	Date: 05/22/2023
Revision: 0	<b>NORM Survey Report</b>	Page: 13 of 20

The P&IDs of the equipments of interest are marked to better illustrate the survey, those P&IDs can be found on ANNEX C of this report.

For the purpose of controlling exposures to ionizing radiation, as well as controlling the generation of radioactive waste, the equipments in item 7 with an indication of the presence of NORM is considered equipment of interest for collecting samples to characterize the waste.



In order to comply with the Brazilian CNEN 8.01 standard, the results of the collected samples must confirm whether the concentration of activity found in the product is within the limit for unconditional disposal or if the oily sludge must be treated as NORM.



JAB-REL-SHE-FLU-007	<b>JABARRA RADIOPROTEÇÃO LTDA</b>	Date: 05/22/2023
Revision: 0	<b>NORM Survey Report</b>	Page: 14 of 20

## **ANNEX A – Radiation Meter Calibration Certificate**

JAB-REL-SHE-FLU-007	<b>JABARRA RADIOPROTEÇÃO LTDA</b>	Date: 05/22/2023
Revision: 0	<b>NORM Survey Report</b>	Page: 15 of 20

	<b>Universidade do Estado do Rio de Janeiro</b> <b>Instituto de Biologia Roberto Alcântara Gomes</b> <b>Laboratório de Ciências Radiológicas</b>	 Acreditado pela CGCRE / INMETRO Certificado pelo CASEC/IRD/CNEN
---	--	---



## CERTIFICADO DE CALIBRAÇÃO

**LCR - 0436/2022**  
Número de Certificado



### SOLICITANTE

**Nome:** 1029 - Jabarra Serviços e Comércio Ltda  
**CNPJ:** 09.066.134/0001-80  
**Endereço:** Rua Madre Maria Victoria , N° 90, Charitas – Niteroi – RJ

### IDENTIFICAÇÃO DO INSTRUMENTO DE MEDIÇÃO / PADRÃO

**Tipo:** Câmara de ionização  
**Fabricante:** PTW – Freiburg  
**Modelo:** TN32002  
**Série:** 489  
**Rastreabilidade:** Rastreado ao LNMRI/IRD/CNEN  
**Última calibração realizada em 04/11/2021 – Certificado LNMRI 1042/2021. ( de acordo com a norma ISO 4037-2, o intervalo de tempo entre calibrações não deve exceder 3 anos )**

**Tipo:** Câmara de ionização  
**Fabricante:** PTW – Freiburg  
**Modelo:** N23361  
**Série:** 292  
**Rastreabilidade:** Rastreado ao LNMRI/IRD/CNEN  
**Última calibração realizada em 04/11/2021 – Certificado LNMRI 1043/2021. ( de acordo com a norma ISO 4037-2, o intervalo de tempo entre calibrações não deve exceder 3 anos )**

### IDENTIFICAÇÃO DO INSTRUMENTO CALIBRADO

**Tipo:** Cintilômetro  
**Fabricante:** Ludlum Measurements Inc  
**Modelo:** 3001  
**Série:** 25019874  
**Sonda:** Ludlum 44-2, n° de série PR-387429

LCR- Rua São Francisco Xavier 524 Pavilhão Haroldo Lisboa da Cunha Sala 136 Térreo. Maracanã. RJ  
 Tel: 2334-0725 / 26 / 27 - e-mail: labmetro.uerj@gmail.com – site: www.labmetroonline.com.br

Página 1/3



JAB-REL-SHE-FLU-007	<b>JABARRA RADIOPROTEÇÃO LTDA</b>	Date: 05/22/2023
Revision: 0	<b>NORM Survey Report</b>	Page: 16 of 20



Laboratório de calibração acreditado pela Cgcre de acordo com a ABNT NBR ISO/IEC 17025, sob número CAL 0625

**LCR. 0436/2022**  
Número de Certificado

#### CONDIÇÕES DA CALIBRAÇÃO

**Geometria:** Eixo longitudinal do detector coincidente com o feixe de radiação.

**Ponto de referência:** Centro geométrico do detector.

**Fonte de radiação:**  $^{137}\text{Cs}$ .

**Faixa de temperatura:** 18 a 26 °C.

**Faixa de pressão:** 970 a 1050 hPa.

**Faixa de umidade relativa do ar:** 30 a 75 %.

#### MÉTODO E PROCEDIMENTOS DE CALIBRAÇÃO

**Método utilizado:** Método de Calibração em Campo de Radiação Conhecido (norma ISO 4037).

**Fonte utilizada:**  $^{137}\text{Cs}$ .

**Procedimentos utilizados:**

- 1- LABMETRO-PT-003- Calibração de Monitores de Radiação dos tipos: Geiger Müller, Proporcional, Cintilômetro e Câmara de Ionização com Fonte Gama.
- 2- LABMETRO- PT-009- Avaliação da Incerteza de Medição.
- 3- LABMETRO-DQ-081 – Modelo de Certificado de Calibração Gama
- 4- O equipamento foi calibrado em um campo de referência caracterizado em taxa equivalente de dose ambiente  $H^*(10)$ .

#### INFORMAÇÕES ADMINISTRATIVAS

**Ordem de serviço LCR/Labmetro:** 279-001/2022

**Laboratório responsável pela calibração:** Labmetro/LCR

#### INFORMAÇÕES

1- O Laboratório de Ciências Radiológicas possui Certificação para Calibração de Instrumentos com Radiação Gama e X, Calibração de Monitores de Contaminação Beta, Calibração de Câmara Poço para Braquiterapia e Irradiação de Monitores Individuais na Grandeza  $H_p(10)$  e com Radiação Gama e X, concedida pelo Comitê de Avaliação de Serviços de Ensaios e Calibração (CASEC) do Instituto de Radioproteção e Dosimetria (IRD) da Comissão Nacional de Energia Nuclear (CNEN) de acordo com as recomendações do documento RT-LCI-001/2011 (*Requisitos técnicos para Certificação de Laboratório de Calibração de Instrumentos de Medição para Radiação Ionizante usados em Radioproteção*).

2- Devido às características do equipamento recomenda-se que o mesmo seja recalibrado periodicamente ou caso ocorra quaisquer danos ou alterações que possam modificar sua resposta.

3- O presente certificado de calibração atende aos requisitos da norma NBR ISO/IEC 17025 e é válido apenas para o instrumento de medição e condições especificadas acima, não sendo extensivo a quaisquer outros instrumentos. O presente certificado de calibração só poderá ser reproduzido por completo, não sendo autorizada cópia de partes do mesmo.

4- De acordo com o documento RT-LCI-001/2011 a calibração foi realizada a 50 % de cada uma das escalas. Os valores medidos devem se situar dentro de  $\pm 10$  % do valor de referência.



JAB-REL-SHE-FLU-007	<b>JABARRA radioproteção LTDA</b>	Date: 05/22/2023
Revision: 0	<b>NORM Survey Report</b>	Page: 17 of 20



Laboratório de calibração acreditado pela Cgcre de acordo com a ABNT NBR ISO/IEC 17025, sob número CAL 0625

**LCR. 0436/2022**  
Número de Certificado

**RESULTADOS**

As incertezas padrão expandidas declaradas neste certificado foram calculadas de acordo com as recomendações do GUM (Guia para a Expressão da Incerteza de Medição - Avaliação de Dados de Medição, INMETRO), para um fator de abrangência  $k = 2$ , com nível de confiança de aproximadamente 95 %.

Valor de referência	Medida do instrumento		Incerteza expandida U (%)
	Antes do ajuste	Depois do ajuste	
Taxa de equivalente de dose ambiente $H^*(10)$			
5,00 $\mu\text{Sv/h}$	5,48 $\mu\text{Sv/h}$	Sem ajustes	5,8
25,0 $\mu\text{Sv/h}$	26,8 $\mu\text{Sv/h}$	Sem ajustes	5,8
250 $\mu\text{Sv/h}$	243 $\mu\text{Sv/h}$	Sem ajustes	5,8

**OBS: O ajuste, quando necessário, não faz parte do escopo da acreditação do laboratório.**


Data da calibração: 31 de maio de 2022

Data da emissão do certificado de calibração: 03 de junho de 2022

Técnico Executor: Márcio Alexandre Costa Cruz

Certificado emitido por:

  
Vanessa Mondaini de Castro  
Responsável Técnico Radioproteção

  
Validado em 06/06/2022  
Responsável: Pedro Costa



JAB-REL-SHE-FLU-007	<b>JABARRA RADIOPROTEÇÃO LTDA</b>	Date: 05/22/2023
Revision: 0	<b>NORM Survey Report</b>	Page: 18 of 20

## **ANNEX B – Radiation Meter Operation Test**

JAB-REL-SHE-FLU-007	<b>JABARRA RADIOPROTEÇÃO LTDA</b>	Date: 05/22/2023
Revision: 0	<b>NORM Survey Report</b>	Page: 19 of 20








	<b>Jabarra Radioproteção</b> <b>FOR-JAB-BRA-011</b> <b>Teste de Funcionamento de Medidores de Radiação</b>	Pág: 1 de 1
		Revisão: B

Medidor de Radiação	Fonte Teste
Marca: Ludlum	Radioisótopo: Cs - 137
Modelo: 3001	Atividade: 220 KBq
Número de série: 25019874	Número de série: 59S11
Certificado de Calibração: 436/2022	Data da Atividade: 25/04/2011
Laboratório: LCR	
Data de Emissão: 31/05/2022	

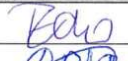

Foto da posição da sonda para medida padrão

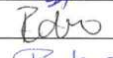Valor Padrão:	3,08 (µSv/h)
Limite Superior:	3,70
Limite Inferior:	2,47

Data	Valor medido (µSv/h)	Responsável	Assinatura
08/08/22	3,08	Pedro Eugenio	
26/08/22	3,22	Pedro Costa	
15/11/22	3,13	Eduardo Andrei	
19/12/22	2,72	Pedro Eugenio	
30/01/23	2,82	Pedro Eugenio	
24/04/23	3,40	Vitor Tim	
01/05/23	3,14	Eduardo Andrei	



JAB-REL-SHE-FLU-007	<b>JABARRA RADIOPROTEÇÃO LTDA</b>	Date: 05/22/2023
Revision: 0	<b>NORM Survey Report</b>	Page: 20 of 20


## **ANNEX C – Marked P&IDs**

PBA-1145A/B/C

OIL TREATER WATER PUMPS  
CAPACITY: 4m<sup>3</sup>/hr (18 gpm) @ ΔP = 690 kPa (100 psi)  
DRIVER : 7.5 kW (10 hp)

MBK-1140A

ELECTROSTATIC TREATER  
VESSEL SIZE: 3050 mm (120") O.D. x 15,240mm (50'-0") S/S  
DOME SIZE: 610 mm O.D. x 2,029 S/S  
DESIGN: 345 kPag (50 psig) @ 93" (200F)  
OPERATING: 90 kPag (13 psig) @ 66" (150F)  
TRANSFORMER RATING: 75 kW

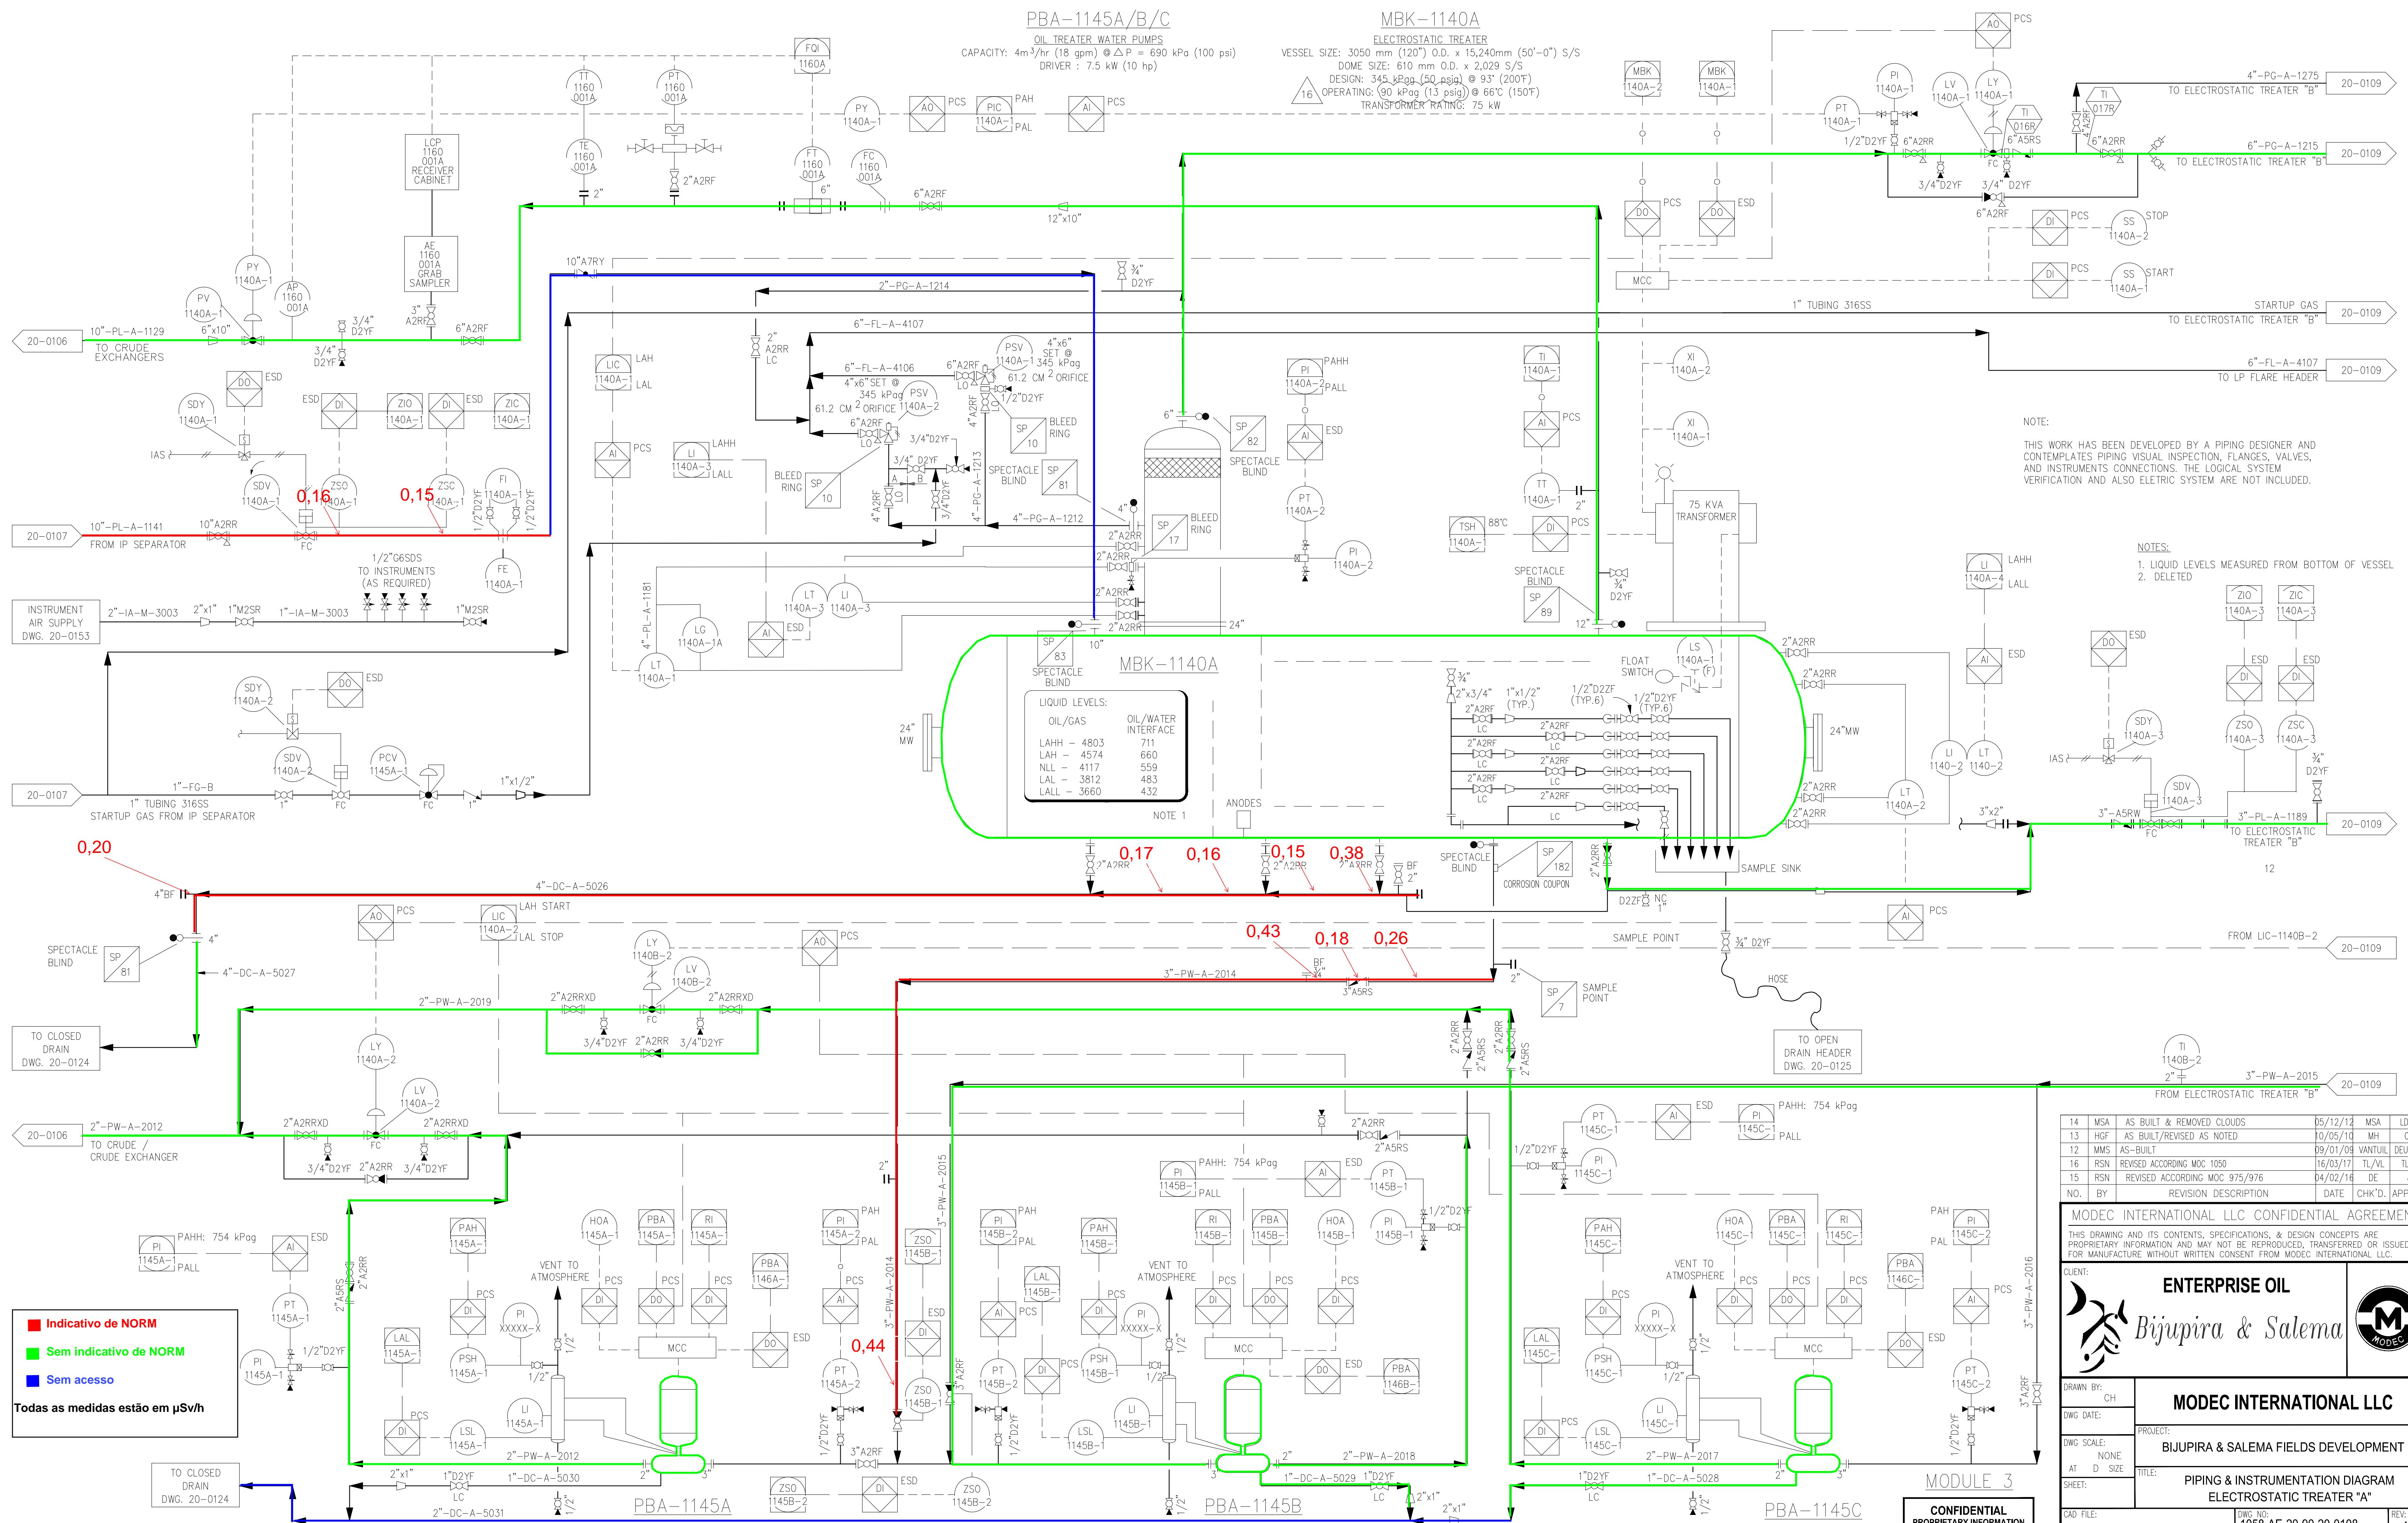

NOTE:  
THIS WORK HAS BEEN DEVELOPED BY A PIPING DESIGNER AND CONTEMPLATES PIPING VISUAL INSPECTION, FLANGES, VALVES, AND INSTRUMENTS CONNECTIONS. THE LOGICAL SYSTEM VERIFICATION AND ALSO ELETRIC SYSTEM ARE NOT INCLUDED.

- NOTES:  
1. LIQUID LEVELS MEASURED FROM BOTTOM OF VESSEL  
2. DELETED

LIQUID LEVELS:

	OIL/GAS	OIL/WATER INTERFACE
LAHH - 4803	711	
LAH - 4574	660	
NLL - 4117	559	
LAL - 3812	483	
LALL - 3660	432	

NO.	BY	REVISION DESCRIPTION	DATE	CHK'D.	APPV'D.
14	MSA	AS BUILT & REMOVED CLOUDS	05/12/12	MSA	LD/RD
13	HGF	AS BUILT/REVISED AS NOTED	10/05/10	MH	CCP
12	MMS	AS-BUILT	09/01/09	VANTUIL	DEUZMAR
16	RSN	REVISED ACCORDING MOC 1050	16/03/17	TL/VL	TL/VL
15	RSN	REVISED ACCORDING MOC 975/976	04/02/16	DE	JG

MODEC INTERNATIONAL LLC CONFIDENTIAL AGREEMENT  
THIS DRAWING AND ITS CONTENTS, SPECIFICATIONS, & DESIGN CONCEPTS ARE PROPRIETARY INFORMATION AND MAY NOT BE REPRODUCED, TRANSFERRED OR ISSUED FOR MANUFACTURE WITHOUT WRITTEN CONSENT FROM MODEC INTERNATIONAL LLC.

CLIENT: **ENTERPRISE OIL**  
*Bijupira & Salema*

**MODEC INTERNATIONAL LLC**

DRAWN BY: CH  
DWG DATE:  
DWG SCALE: NONE  
SHEET: 12

PROJECT: **BIJUPIRA & SALEMA FIELDS DEVELOPMENT**  
TITLE: **PIPING & INSTRUMENTATION DIAGRAM ELECTROSTATIC TREATER "A"**

CAD FILE: 01-20-0108  
DWG NO: 1058-AE-20-90-20-0108  
REV: 1


Indicativo de NORM  
Sem indicativo de NORM  
Sem acesso  
Todas as medidas estão em mSv/h

CONFIDENTIAL  
PROPRIETARY INFORMATION

MBK-1140B

ELECTROSTATIC TREATER

SIZE: 3050 mm (120") O.D. x 15,240mm (50'-0") S/S  
 DOME SIZE: 610 mm O.D. x 2,029 S/S  
 DESIGN: 345 kPag (50 psia) @ 93° (200F)  
 OPERATING: 90 kPag (13 psig) @ 66°C (150F)  
 TRANSFORMER RATING: 75 kW

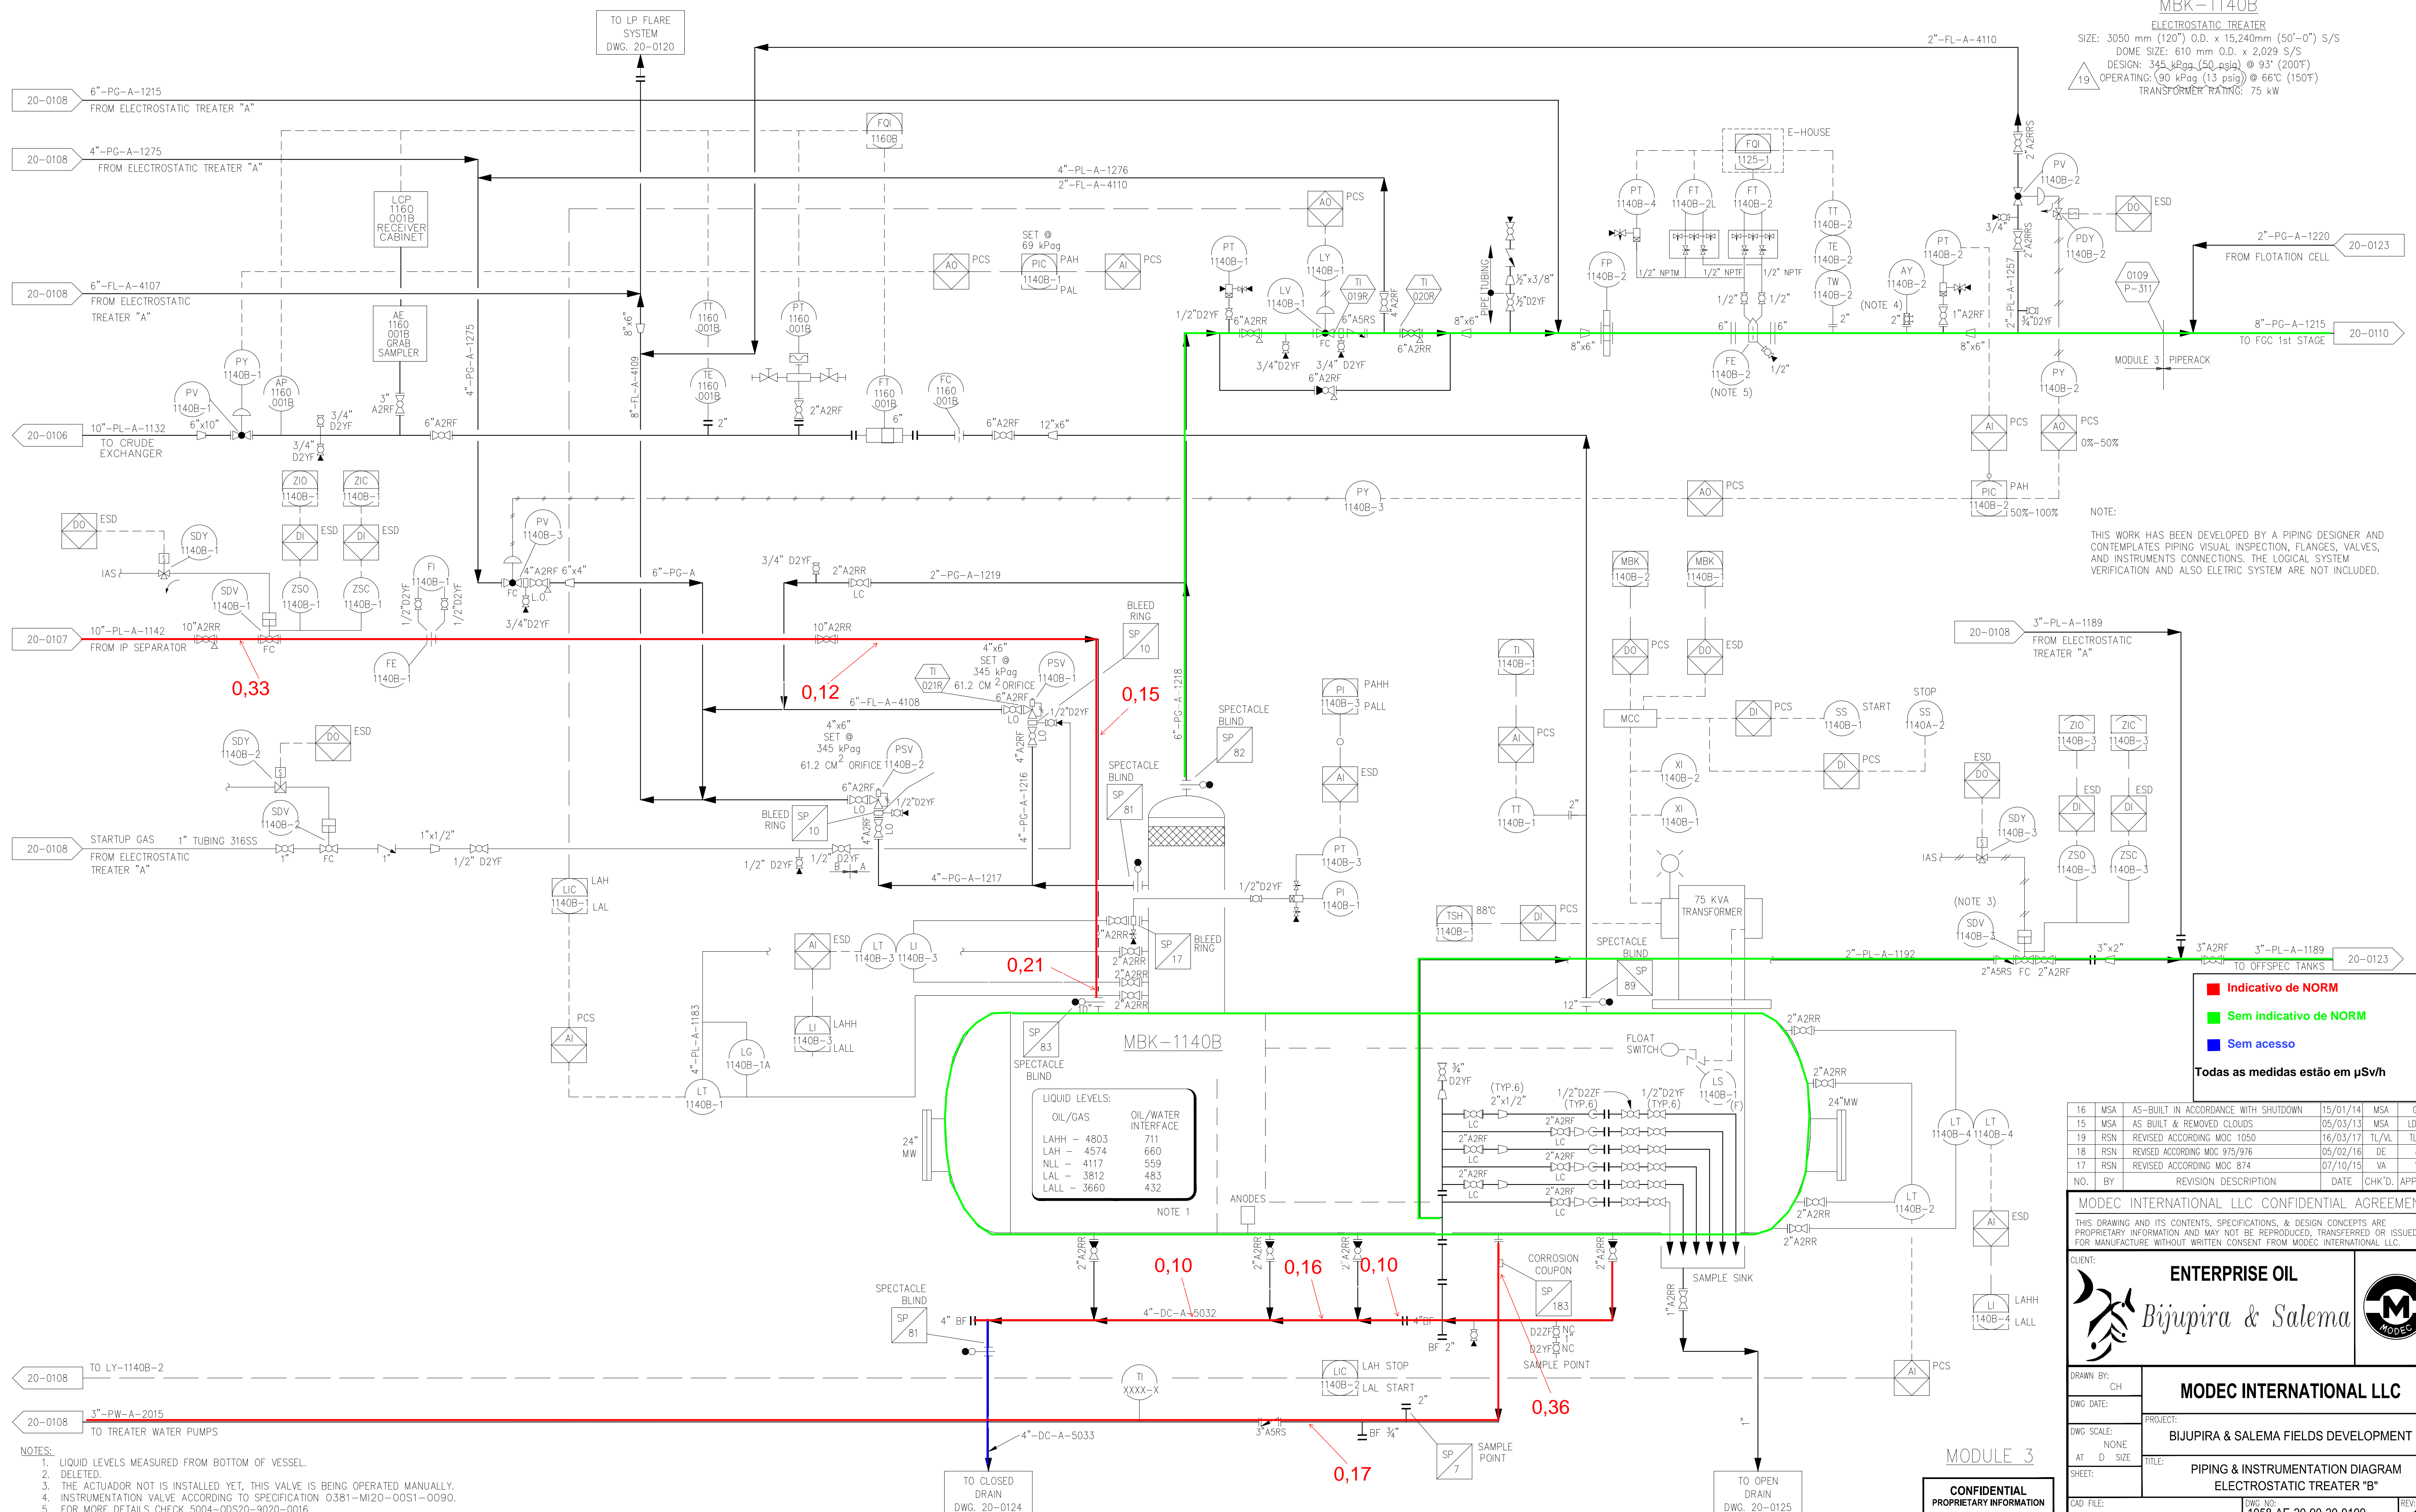

NOTE:  
 THIS WORK HAS BEEN DEVELOPED BY A PIPING DESIGNER AND  
 CONTEMPLATES PIPING VISUAL INSPECTION, FLANGES, VALVES,  
 AND INSTRUMENTS CONNECTIONS. THE LOGICAL SYSTEM  
 VERIFICATION AND ALSO ELETIC SYSTEM ARE NOT INCLUDED.

■ Indicativo de NORM  
 ■ Sem indicativo de NORM  
 ■ Sem acesso  
 Todas as medidas estão em µSv/h

16	MSA	AS-BUILT IN ACCORDANCE WITH SHUTDOWN	15/01/14	MSA	GBT
15	MSA	AS BUILT & REMOVED CLOUDS	05/03/13	MSA	LD/RD
19	RSN	REVISED ACCORDING MOC 1050	16/03/17	TL/VL	TL/VL
18	RSN	REVISED ACCORDING MOC 975/976	05/02/16	DE	JG
17	RSN	REVISED ACCORDING MOC 874	07/10/15	VA	VA
NO.	BY	REVISION DESCRIPTION	DATE	CHK'D.	APPV'D.

MODEC INTERNATIONAL LLC CONFIDENTIAL AGREEMENT  
 THIS DRAWING AND ITS CONTENTS, SPECIFICATIONS, & DESIGN CONCEPTS ARE  
 PROPRIETARY INFORMATION AND MAY NOT BE REPRODUCED, TRANSFERRED OR ISSUED  
 FOR MANUFACTURE WITHOUT WRITTEN CONSENT FROM MODEC INTERNATIONAL LLC.

CLIENT: **ENTERPRISE OIL**  
*Bijupira & Salema*

**MODEC INTERNATIONAL LLC**

DRAWN BY: CH  
 DWG DATE:  
 DWG SCALE: NONE  
 AT D SIZE  
 SHEET:


PROJECT: **BIJUPIRA & SALEMA FIELDS DEVELOPMENT**  
 TITLE: **PIPING & INSTRUMENTATION DIAGRAM  
 ELECTROSTATIC TREATER "B"**

CAD FILE: 01-20-0109  
 DWG NO: 1058-AE-20-90-20-0109  
 REV:

- NOTES:  
 1. LIQUID LEVELS MEASURED FROM BOTTOM OF VESSEL.  
 2. DELETED.  
 3. THE ACTUATOR NOT IS INSTALLED YET, THIS VALVE IS BEING OPERATED MANUALLY.  
 4. INSTRUMENTATION VALVE ACCORDING TO SPECIFICATION 0381-MI20-00S1-0090.  
 5. FOR MORE DETAILS CHECK 5004-ODS20-9020-0016.

LIQUID LEVELS:

	OIL/GAS	OIL/WATER INTERFACE
LAHH	- 4803	711
LAH	- 4574	660
NLL	- 4117	559
LAL	- 3812	483
LALL	- 3660	432

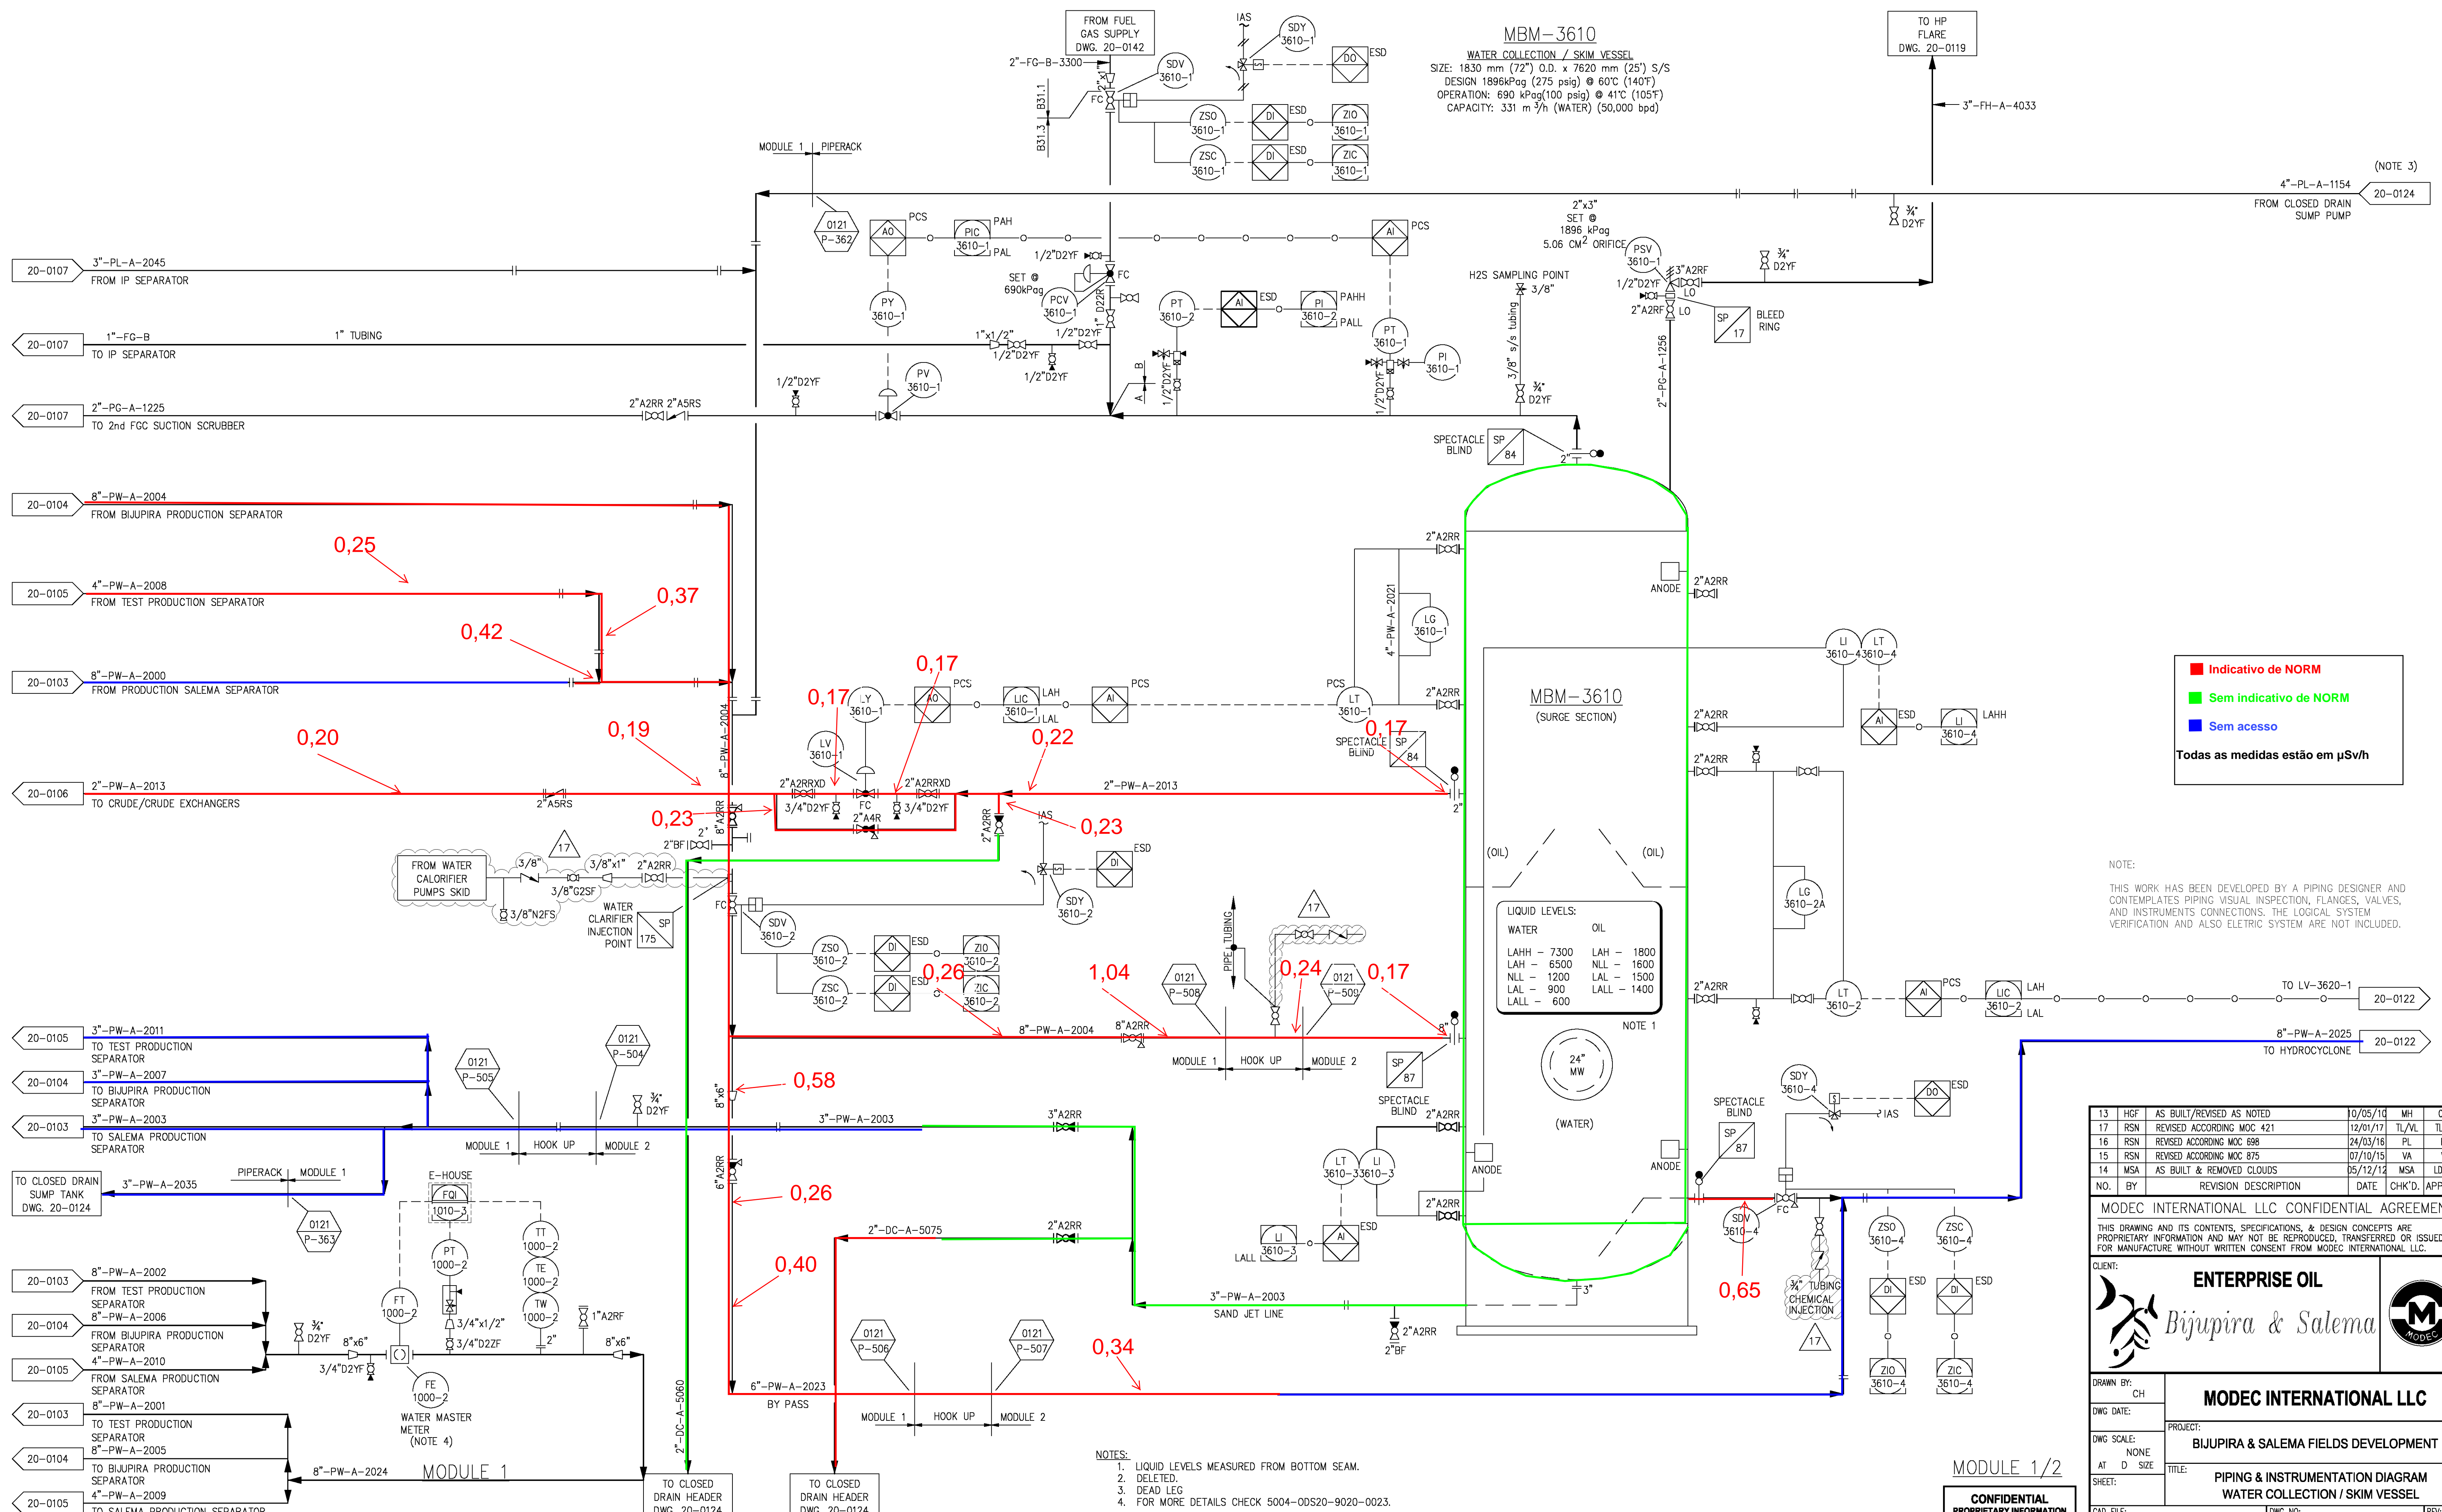

**MBM-3610**  
 WATER COLLECTION / SKIM VESSEL  
 SIZE: 1830 mm (72") O.D. x 7620 mm (25') S/S  
 DESIGN 1896kPag (275 psig) @ 60°C (140°F)  
 OPERATION: 690 kPag (100 psig) @ 41°C (105°F)  
 CAPACITY: 331 m<sup>3</sup>/h (WATER) (50,000 bpd)

**Indicativo de NORM**  
 Sem indicativo de NORM  
 Sem acesso  
 Todas as medidas estão em µSv/h

NOTE:  
 THIS WORK HAS BEEN DEVELOPED BY A PIPING DESIGNER AND CONTEMPLATES PIPING VISUAL INSPECTION, FLANGES, VALVES, AND INSTRUMENTS CONNECTIONS. THE LOGICAL SYSTEM VERIFICATION AND ALSO ELCTRIC SYSTEM ARE NOT INCLUDED.

LIQUID LEVELS:

WATER	OIL
LAHH - 7300	LAH - 1800
LAH - 6500	NLL - 1600
NLL - 1200	LAL - 1500
LAL - 900	LALL - 1400
LALL - 600	

NOTE 1

13	HGF	AS BUILT/REVISED AS NOTED	10/05/10	MH	CCP
17	RSN	REVISED ACCORDING MOC 421	12/01/17	TL/VL	TL/VL
16	RSN	REVISED ACCORDING MOC 698	24/03/18	PL	PL
15	RSN	REVISED ACCORDING MOC 875	07/10/15	VA	VA
14	MSA	AS BUILT & REMOVED CLOUDS	05/12/12	MSA	LD/RD
NO.	BY	REVISION DESCRIPTION	DATE	CHK'D.	APPV'D.

MODEC INTERNATIONAL LLC CONFIDENTIAL AGREEMENT  
 THIS DRAWING AND ITS CONTENTS, SPECIFICATIONS, & DESIGN CONCEPTS ARE PROPRIETARY INFORMATION AND MAY NOT BE REPRODUCED, TRANSFERRED OR ISSUED FOR MANUFACTURE WITHOUT WRITTEN CONSENT FROM MODEC INTERNATIONAL LLC.

CLIENT: **ENTERPRISE OIL**  
*Bijupira & Salema*



**MODEC INTERNATIONAL LLC**

DRAWN BY: CH  
 DWG DATE:  
 DWG SCALE: NONE  
 SHEET: AT D SIZE  
 PROJECT: BIJUPIRA & SALEMA FIELDS DEVELOPMENT  
 TITLE: PIPING & INSTRUMENTATION DIAGRAM WATER COLLECTION / SKIM VESSEL

CAD FILE: 01-20-0121  
 DWG NO: 1058-AE-20-90-20-0121  
 REV:

- NOTES:
- LIQUID LEVELS MEASURED FROM BOTTOM SEAM.
  - DELETED.
  - DEAD LEG
  - FOR MORE DETAILS CHECK 5004-ODS20-9020-0023.

MODULE 1/2  
 CONFIDENTIAL  
 PROPRIETARY INFORMATION

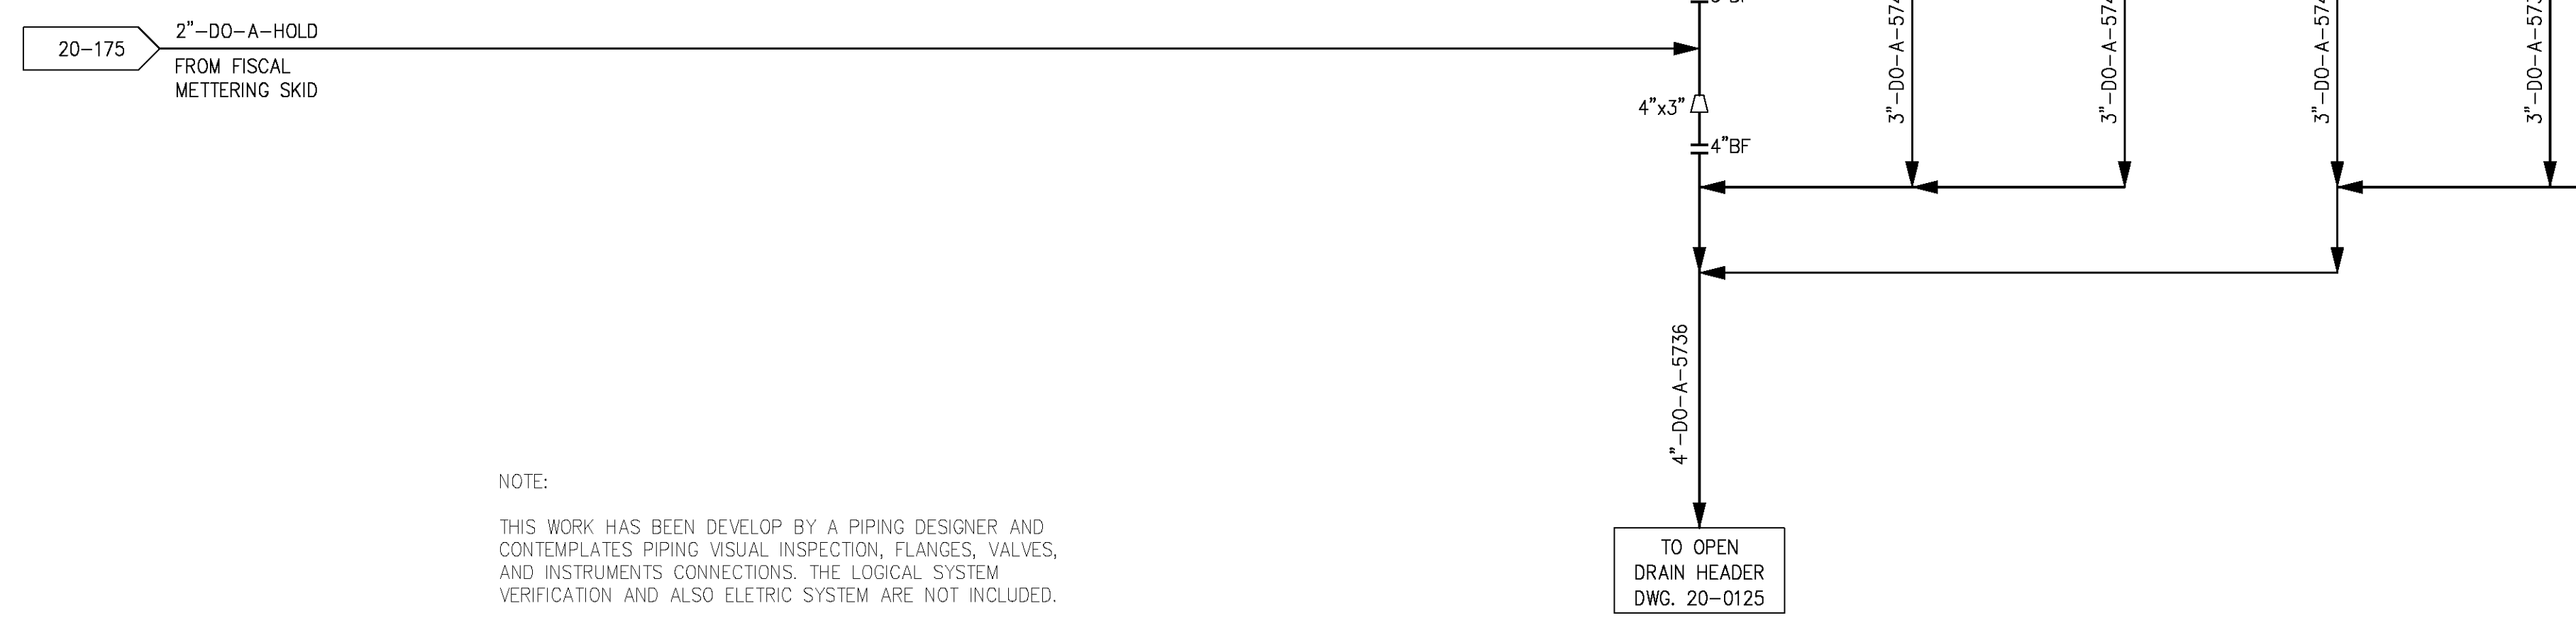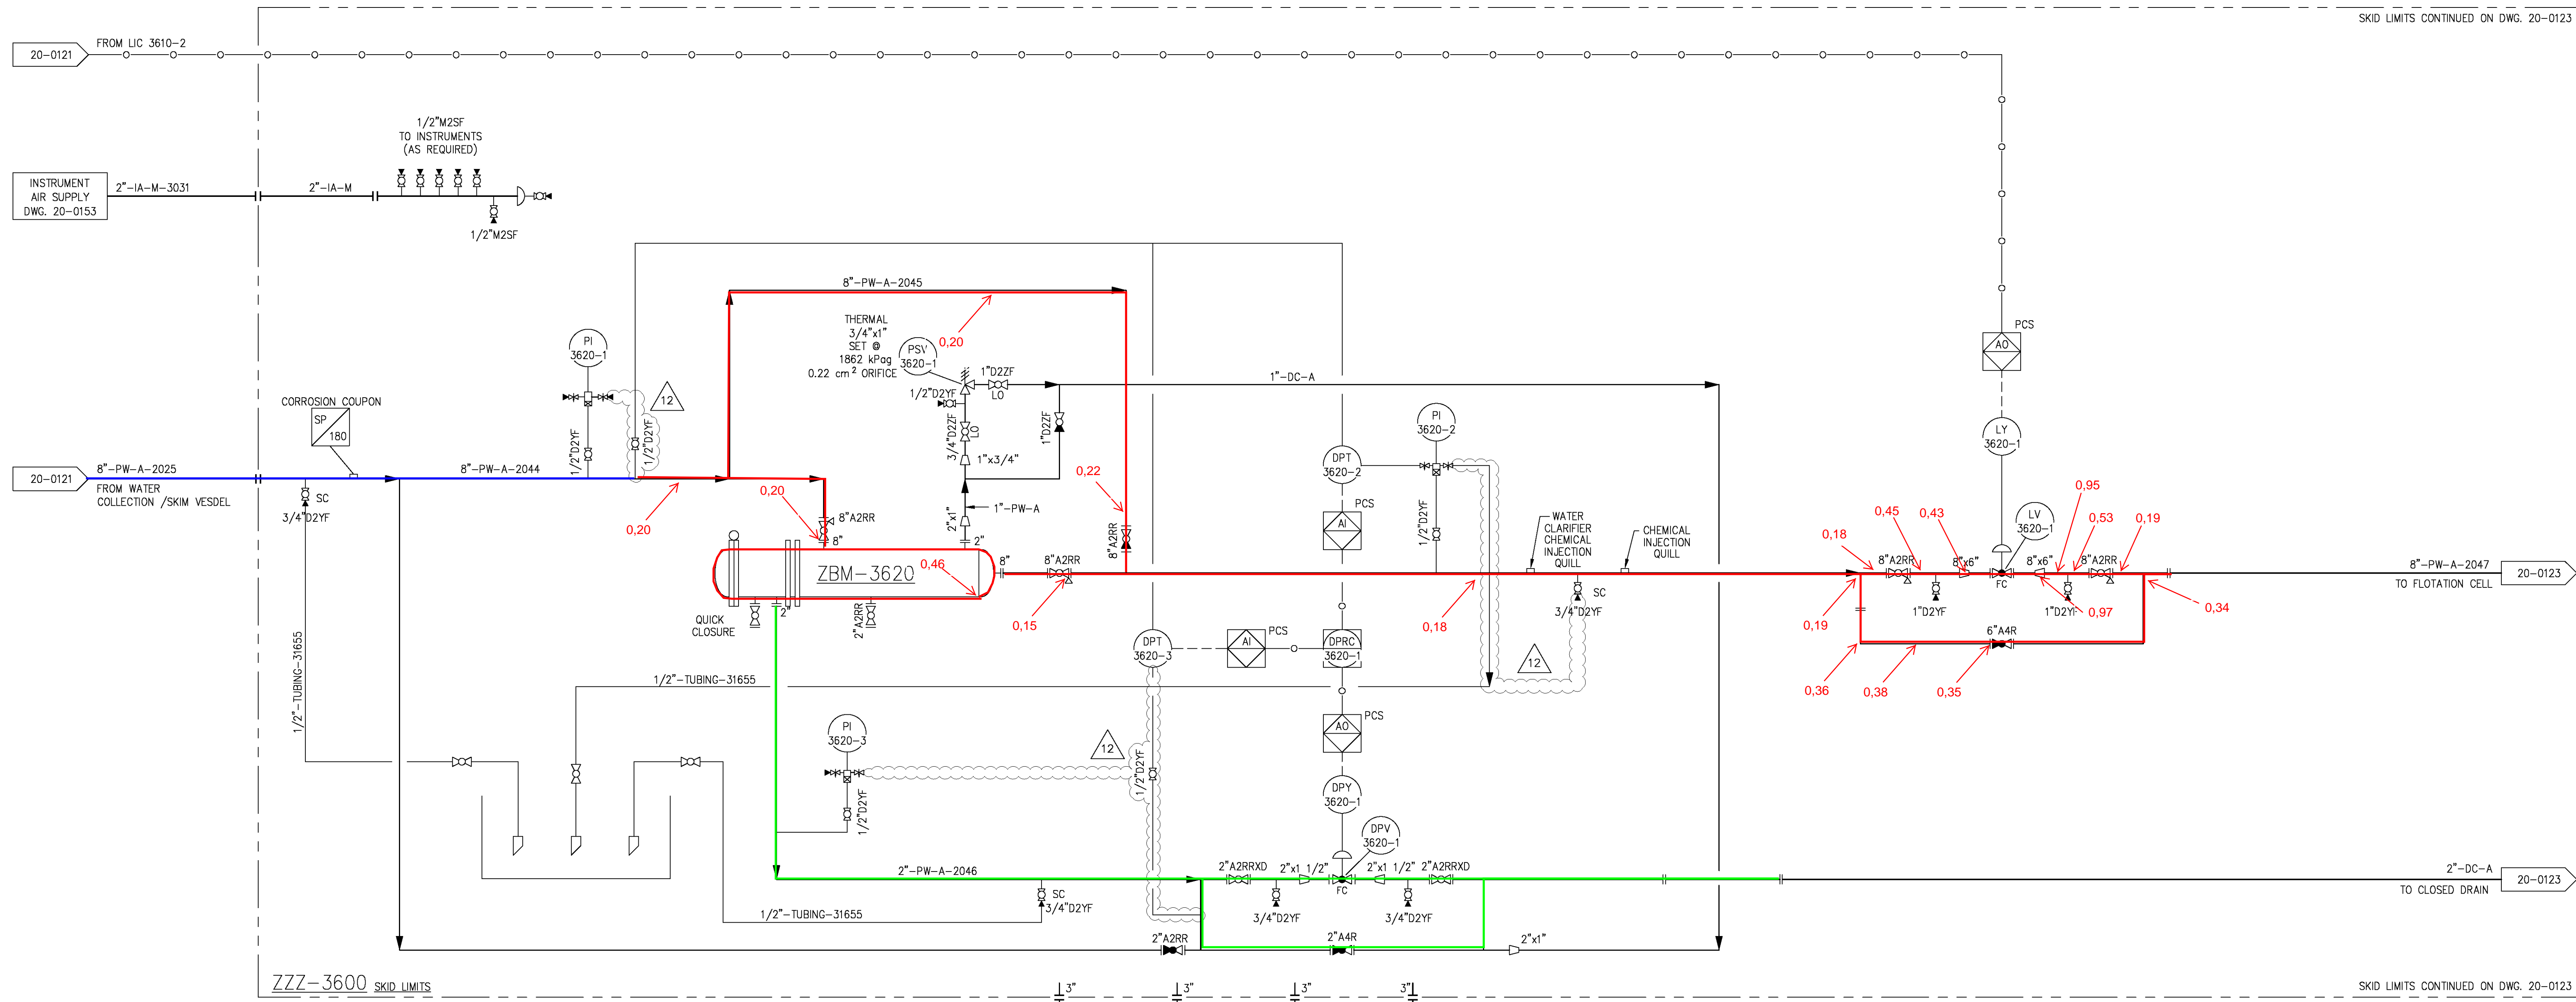

NOTE:  
THIS WORK HAS BEEN DEVELOPED BY A PIPING DESIGNER AND CONTEMPLATES PIPING VISUAL INSPECTION, FLANGES, VALVES, AND INSTRUMENTS CONNECTIONS. THE LOGICAL SYSTEM VERIFICATION AND ALSO ELECTRIC SYSTEM ARE NOT INCLUDED.

Indicativo de NORM  
Sem indicativo de NORM  
Sem acesso  
Todas as medidas estão em µSv/h

MODULE 2

CONFIDENTIAL  
PROPRIETARY INFORMATION

NO.	BY	REVISION DESCRIPTION	DATE	CHK'D.	APPV'D.
11	MSA	AS BUILT & REMOVED CLOUDS	10/10/12	MSA	LD/RD
10	HCF	AS BUILT/REVISED AS NOTED	10/05/10	MH	CCP
9	MMS	AS BUILT	09/01/09	VANTUIL	DEUZIMAR
8	HCF	REVISED AS NOTED	05/15/08	CC	
12	RSN	REVISED ACCORDING MOC 1282	08/01/12	TL/VL	TL/VL
11	MSA	AS BUILT & REMOVED CLOUDS	10/10/12	MSA	LD/RD

MODEC INTERNATIONAL LLC CONFIDENTIAL AGREEMENT  
THIS DRAWING AND ITS CONTENTS, SPECIFICATIONS, & DESIGN CONCEPTS ARE PROPRIETARY INFORMATION AND MAY NOT BE REPRODUCED, TRANSFERRED OR ISSUED FOR MANUFACTURE WITHOUT WRITTEN CONSENT FROM MODEC INTERNATIONAL LLC.

CLIENT:  
**ENTERPRISE OIL**  
*Bijupira & Salema*

DRAWN BY: CB  
DWG DATE:  
DWG SCALE: NONE AT D SIZE  
SHEET:  
PROJECT: **MODEC INTERNATIONAL LLC**  
**BIJUPIRA & SALEMA FIELDS DEVELOPMENT**  
TITLE: **PIPING & INSTRUMENTATION DIAGRAM HYDROCYCLONE**



ABH-3410


CLOSED DRAIN SUMP TANK

SIZE: 1220 mm (48") OD x 3050 mm (10') S/S  
 DESIGN: 676 kPa(g) (98 psig) @ -45°C/66°C (-49°F)/(150°F)  
 OPERATING: 28 kPa(g) BARG (4 psig) @ -35°C/38°C (-31°F/100°F)

PBE-3415A/B

CLOSED DRAIN SUMP PUMPS

CAPACITY: 28.4 m<sup>3</sup>/h (125 gpm) CPM @ ΔP = 1034 kPa(g) (150 psig)  
 DRIVER: 30 kW (40 hp)

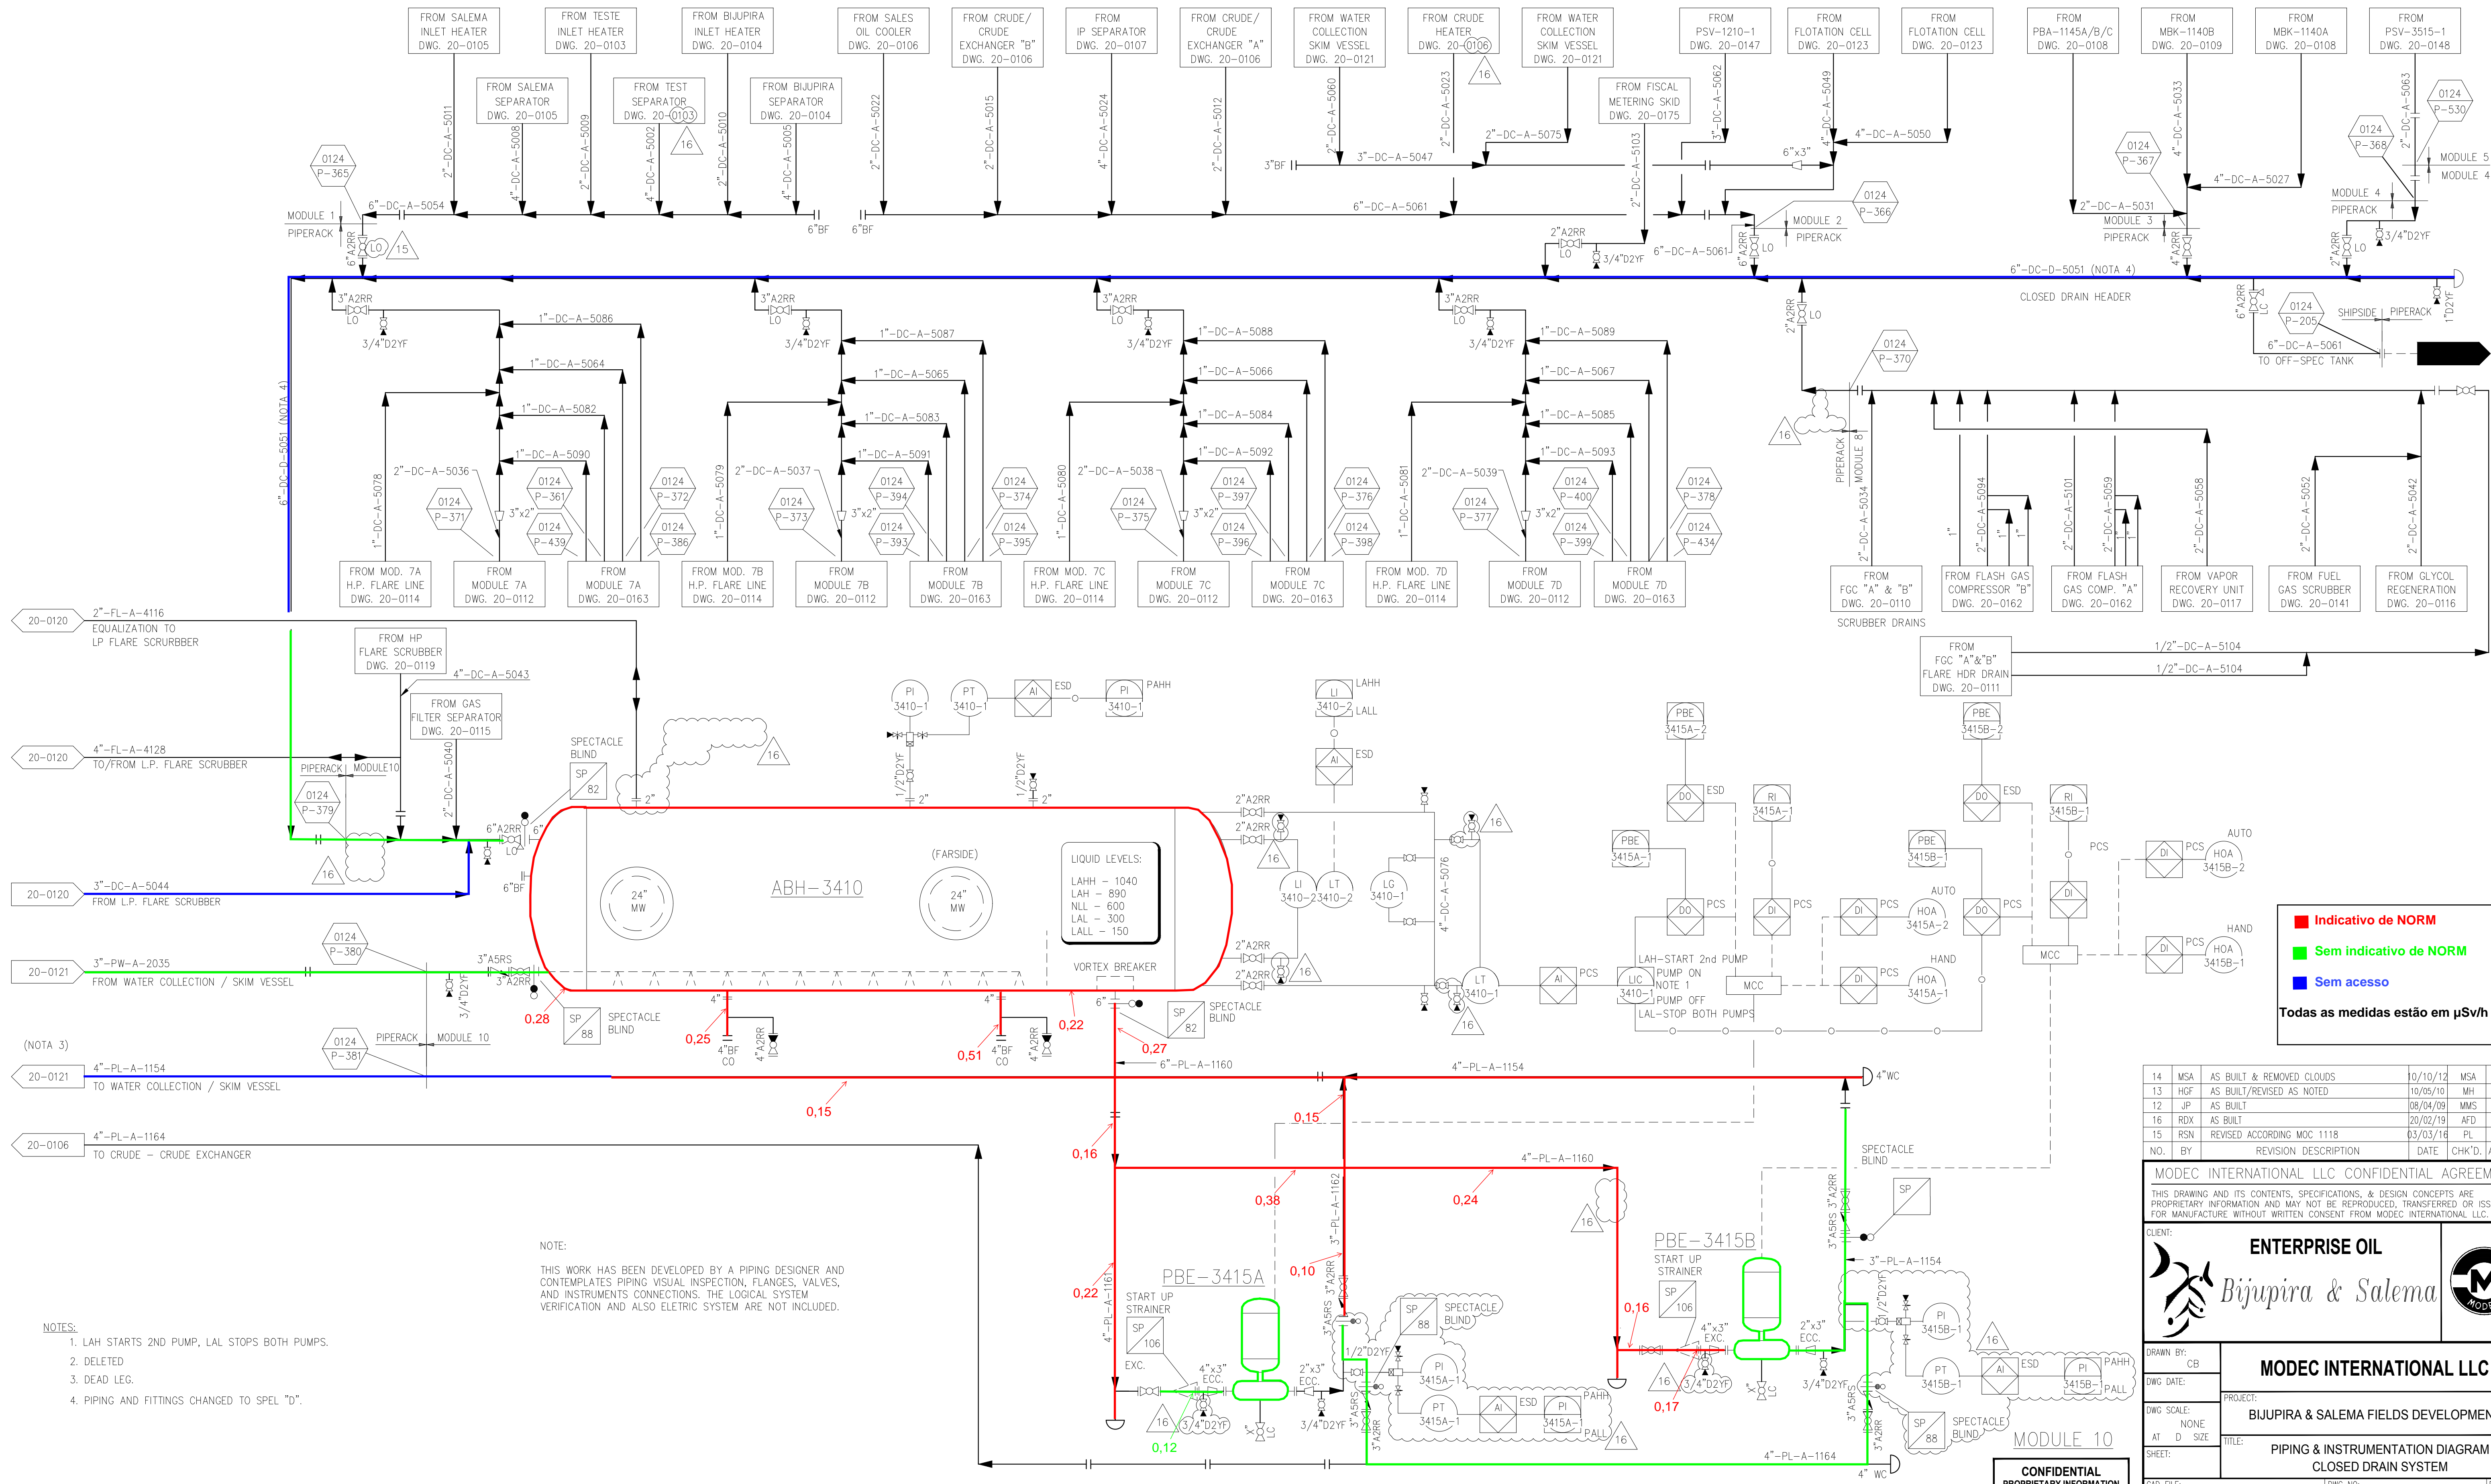

- 20-0120 2"-FL-A-4116  
EQUALIZATION TO  
LP FLARE SCRUBBER
- 20-0120 4"-FL-A-4128  
TO/FROM L.P. FLARE SCRUBBER
- 20-0120 3"-DC-A-5044  
FROM L.P. FLARE SCRUBBER
- 20-0121 3"-PW-A-2035  
FROM WATER COLLECTION / SKIM VESSEL
- (NOTA 3)
- 20-0121 4"-PL-A-1154  
TO WATER COLLECTION / SKIM VESSEL
- 20-0106 4"-PL-A-1164  
TO CRUDE - CRUDE EXCHANGER

NOTE:  
 THIS WORK HAS BEEN DEVELOPED BY A PIPING DESIGNER AND  
 CONTEMPLATES PIPING VISUAL INSPECTION, FLANGES, VALVES,  
 AND INSTRUMENTS CONNECTIONS. THE LOGICAL SYSTEM  
 VERIFICATION AND ALSO ELETRIC SYSTEM ARE NOT INCLUDED.

- NOTES:
1. LAH STARTS 2ND PUMP, LAL STOPS BOTH PUMPS.
  2. DELETED
  3. DEAD LEG.
  4. PIPING AND FITTINGS CHANGED TO SPEL "D".

14	MSA	AS BUILT & REMOVED CLOUDS	10/10/12	MSA	LD/RD
13	HGF	AS BUILT/REVISED AS NOTED	10/05/10	MH	CCP
12	JP	AS BUILT	08/04/09	MMS	DEU2MAR
16	RDX	AS BUILT	20/02/19	AFD	DFG
15	RSN	REVISED ACCORDING MOC 1118	03/03/16	PL	PL
NO.	BY	REVISION DESCRIPTION	DATE	CHK'D.	APP'V'D.

MODEC INTERNATIONAL LLC CONFIDENTIAL AGREEMENT  
 THIS DRAWING AND ITS CONTENTS, SPECIFICATIONS, & DESIGN CONCEPTS ARE  
 PROPRIETARY INFORMATION AND MAY NOT BE REPRODUCED, TRANSFERRED OR ISSUED  
 FOR MANUFACTURE WITHOUT WRITTEN CONSENT FROM MODEC INTERNATIONAL LLC.

CLIENT:  
**ENTERPRISE OIL**  
*Bijupira & Salema*


**MODEC INTERNATIONAL LLC**

PROJECT:  
**BIJUPIRA & SALEMA FIELDS DEVELOPMENT**

TITLE:  
**PIPING & INSTRUMENTATION DIAGRAM  
 CLOSED DRAIN SYSTEM**

PBE-1210

FLOWLINE CIRCULATION PUMP  
 CAPACITY: 182 m<sup>3</sup>/h (800 gpm) @ ΔP=4140 kPa (600 psi)  
 DRIVER: 375 kW (500 hp)  
 800 gpm 4554 OPERATING

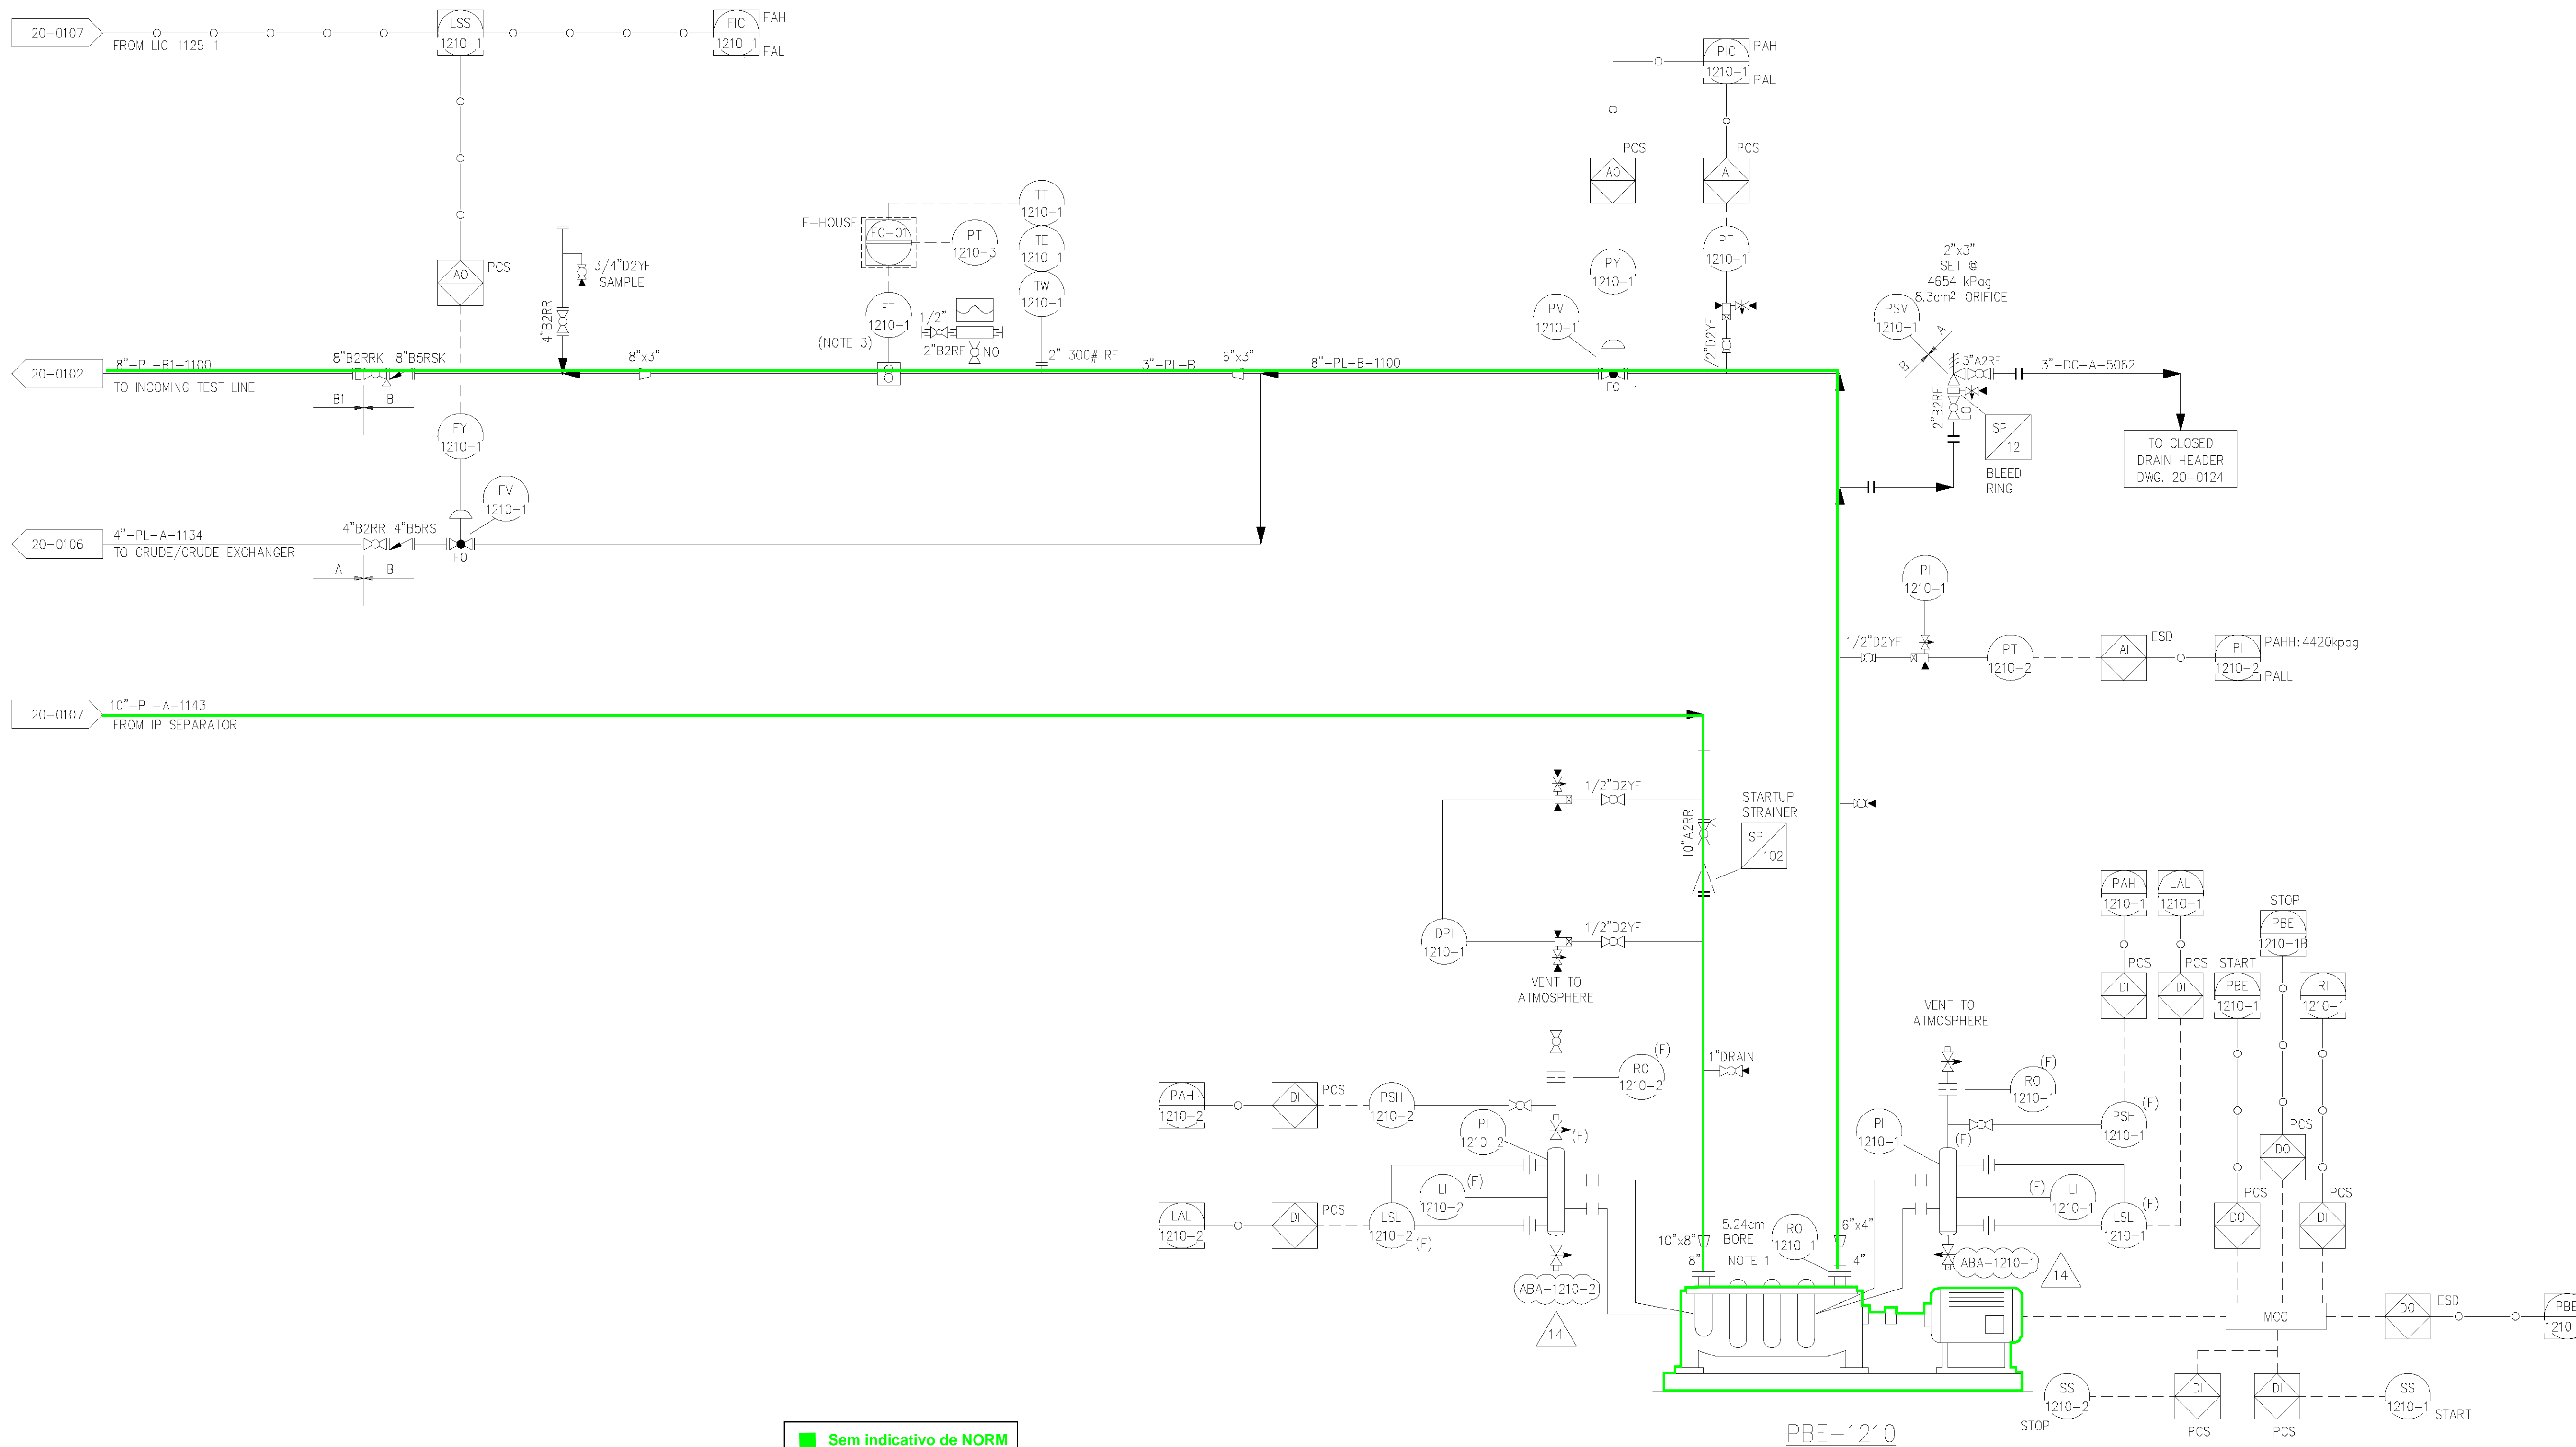

■ Sem indicativo de NORM

NOTE:  
 THIS WORK HAS BEEN DEVELOPED BY A PIPING DESIGNER AND CONTEMPLATES PIPING VISUAL INSPECTION, FLANGES, VALVES, AND INSTRUMENT CONNECTIONS. THE LOGICAL SYSTEM VERIFICATION AND ALSO ELETRIC SYSTEM ARE NOT INCLUDED.

- NOTES:  
 1. PUMP FLANGES ARE 900# ANSI.  
 2. DELETED.  
 3. FOR MORE DETAILS CHECK 5004-0DS20-9020-0008.

12	MSA	AS-BUILT IN ACCORDANCE WITH SHUTDOWN	16/01/14	MSA	GBT
11	MSA	AS BUILT & REMOVED CLOUDS	05/12/12	MSA	LD/RD
10	HGF	AS BUILT/REVISED AS NOTED	10/05/10	MH	CCP
14	RSN	TACS ADDED TO EQUIPMENT AS PER AREA	19/04/17	TC	TC
13	RSN	REVISED ACCORDING MOC 876	07/10/15	VA	VA
NO.	BY	REVISION DESCRIPTION	DATE	CHK'D,	APPV'D.

MODEC INTERNATIONAL LLC CONFIDENTIAL AGREEMENT  
 THIS DRAWING AND ITS CONTENTS, SPECIFICATIONS, & DESIGN CONCEPTS ARE PROPRIETARY INFORMATION AND MAY NOT BE REPRODUCED, TRANSFERRED OR ISSUED FOR MANUFACTURE WITHOUT WRITTEN CONSENT FROM MODEC INTERNATIONAL LLC.

CLIENT: **ENTERPRISE OIL**  
*Bijupira & Salema*

DRAWN BY: DB	<b>MODEC INTERNATIONAL LLC</b>
DWG DATE:	PROJECT: BIJUPIRA & SALEMA FIELDS DEVELOPMENT
DWG SCALE: NONE	TITLE: PIPING & INSTRUMENTATION DIAGRAM
AT D SIZE	FLOWLINE CIRCULATION PUMP
SHEET:	

MODULE 2

CONFIDENTIAL PROPRIETARY INFORMATION


CAD FILE: 01-20-0147	DWG NO: 1058-AE-20-90-20-0147	REV: 1
----------------------	-------------------------------	--------

HBG-1050

SALEMA INLET HEATER
DESIGN: SHELL: 1596 kPag (230 psig) @ 149C (300F)
TUBE: 4516 kPag (655 psig) @ 149C (300F)
MDMT: -18C (0F)
OPERATING: SHELL: 345 kPag (50 psig) @ 135C (275F)
TUBE: 1172 kPag (170 psig) @ 41C (105F)
DUTY: 5000 kW (17 MMBtu/h)

MBD-1010

SALEMA PRODUCTION SEPARATOR
SIZE: 3048 mm (120") O.D. x 12192 mm (40') S/S
DESIGN: 1896 kPag (275 psig) @ 80C (140F)
MDMT: -29C (-20F)
OPERATING: 1034 kPag (150 psig) @ 41C (105F)

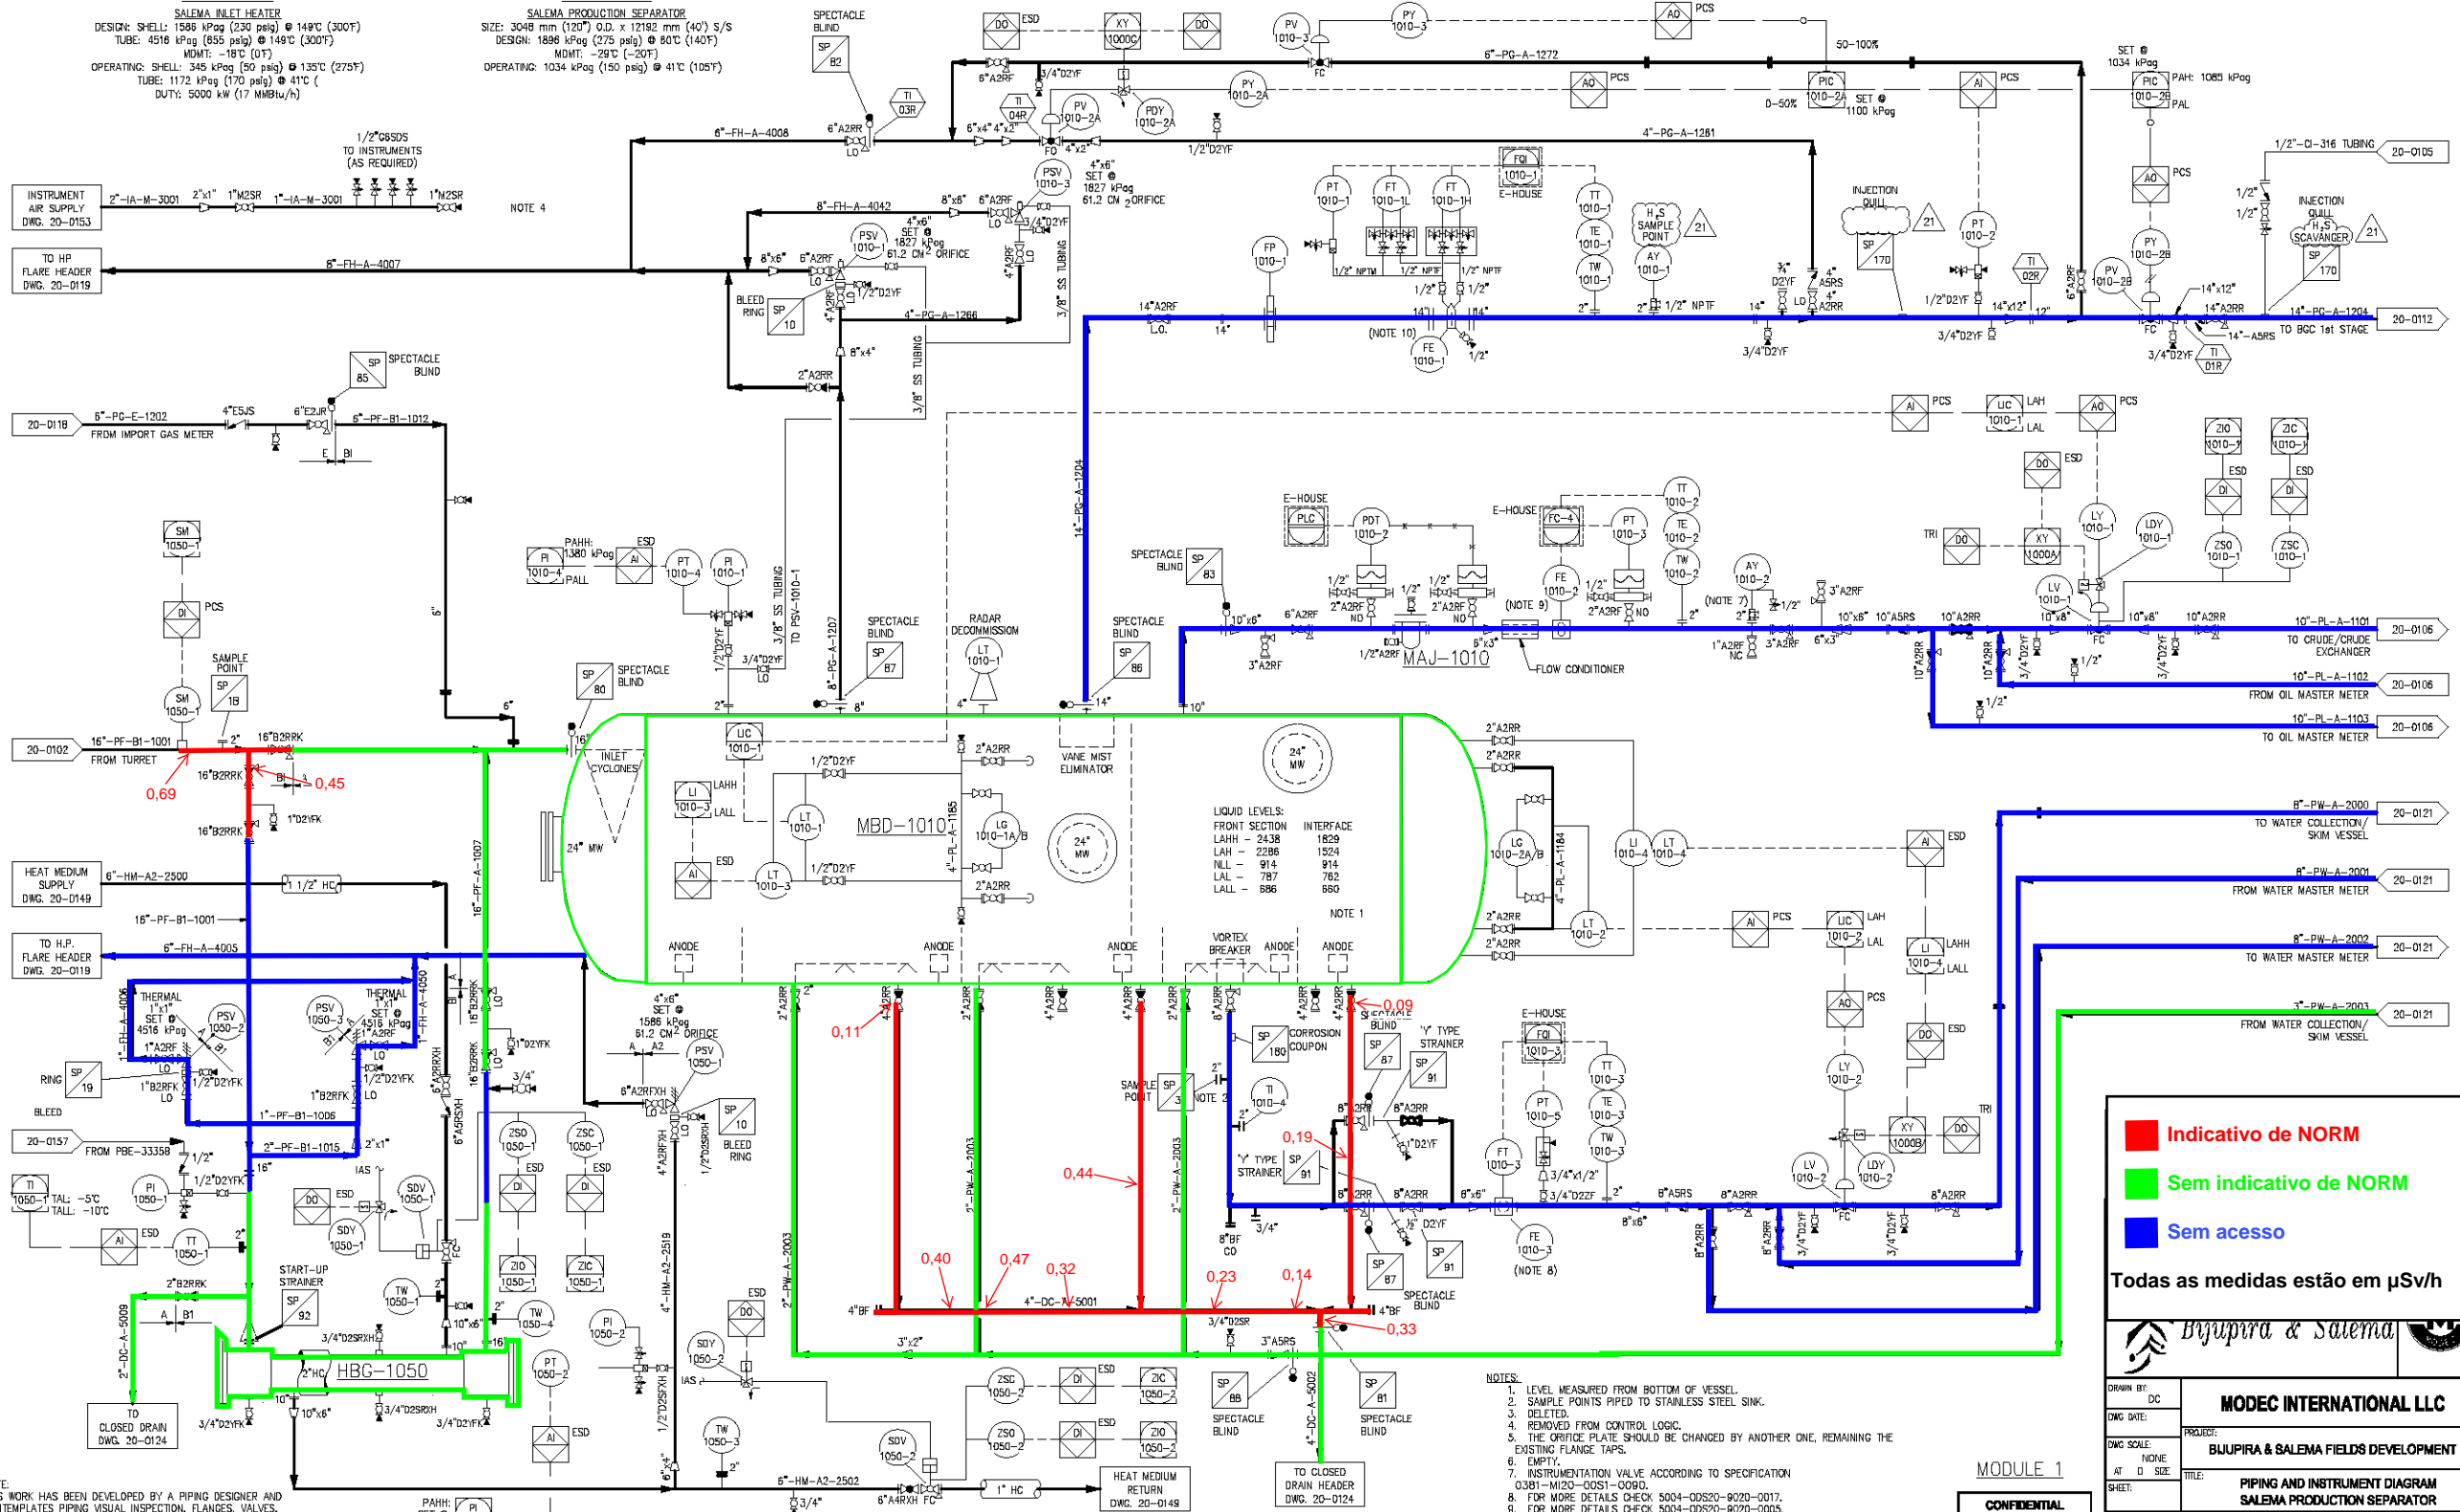

NOTE 4

NOTE 1

- NOTES:
1. LEVEL MEASURED FROM BOTTOM OF VESSEL.
2. SAMPLE POINTS PIPED TO STAINLESS STEEL SINK.
3. DELETED.
4. REMOVED FROM CONTROL LOGIC.
5. THE ORIFICE PLATE SHOULD BE CHANGED BY ANOTHER ONE, REMAINING THE EXISTING FLANGE TAPS.
6. EMPTY.
7. INSTRUMENTATION VALVE ACCORDING TO SPECIFICATION 0381-M100-00S1-0090.
8. FOR MORE DETAILS CHECK 5004-0DS20-9020-0017.
9. FOR MORE DETAILS CHECK 5004-0DS20-9020-0005.
10. FOR MORE DETAILS CHECK 5004-0DS20-9020-0008.

Indicativo de NORM
Sem indicativo de NORM
Sem acesso
Todas as medidas estão em µSv/h

MODEC INTERNATIONAL LLC
BUJPIRA & SALEMA FIELDS DEVELOPMENT
PIPING AND INSTRUMENT DIAGRAM
SALEMA PRODUCTION SEPARATOR
MODULE 1
CONFIDENTIAL PROPRIETARY INFORMATION


NOTE: THIS WORK HAS BEEN DEVELOPED BY A PIPING DESIGNER AND CONTEMPLATES PIPING VISUAL INSPECTION, FLANGES, VALVES, AND INSTRUMENT CONNECTIONS. THE LOGICAL SYSTEM VERIFICATION AND ALSO ELCTRIC SYSTEM ARE NOT INCLUDED.

HBC-1055

BIJUPIRA INLET HEATER  
 DESIGN: SHELL: 1586 kPag (230 psig) @ 149°C (300°F)  
 TUBE: 4516 kPag (655 psig) @ 149°C (300°F)  
 MDMT: -18°C (0°F)  
 OPERATING: SHELL: 345 kPag (50 psig) @ 135°C (275°F)  
 TUBE: 1172 kPag (170 psig) @ 41°C (105°F)  
 DUTY: 5000 kW (17 MMBtu/h)

MBD-1015

BIJUPIRA PRODUCTION SEPARATOR  
 SIZE: 3048 mm (120") O.D. x 12192 mm (40') S/S  
 DESIGN: 1896 kPag (275 psig) @ 60°C (140°F)  
 MDMT: -29°C (-20°F)  
 OPERATING: 1034 kPag (150 psig) @ 41°C (105°F)

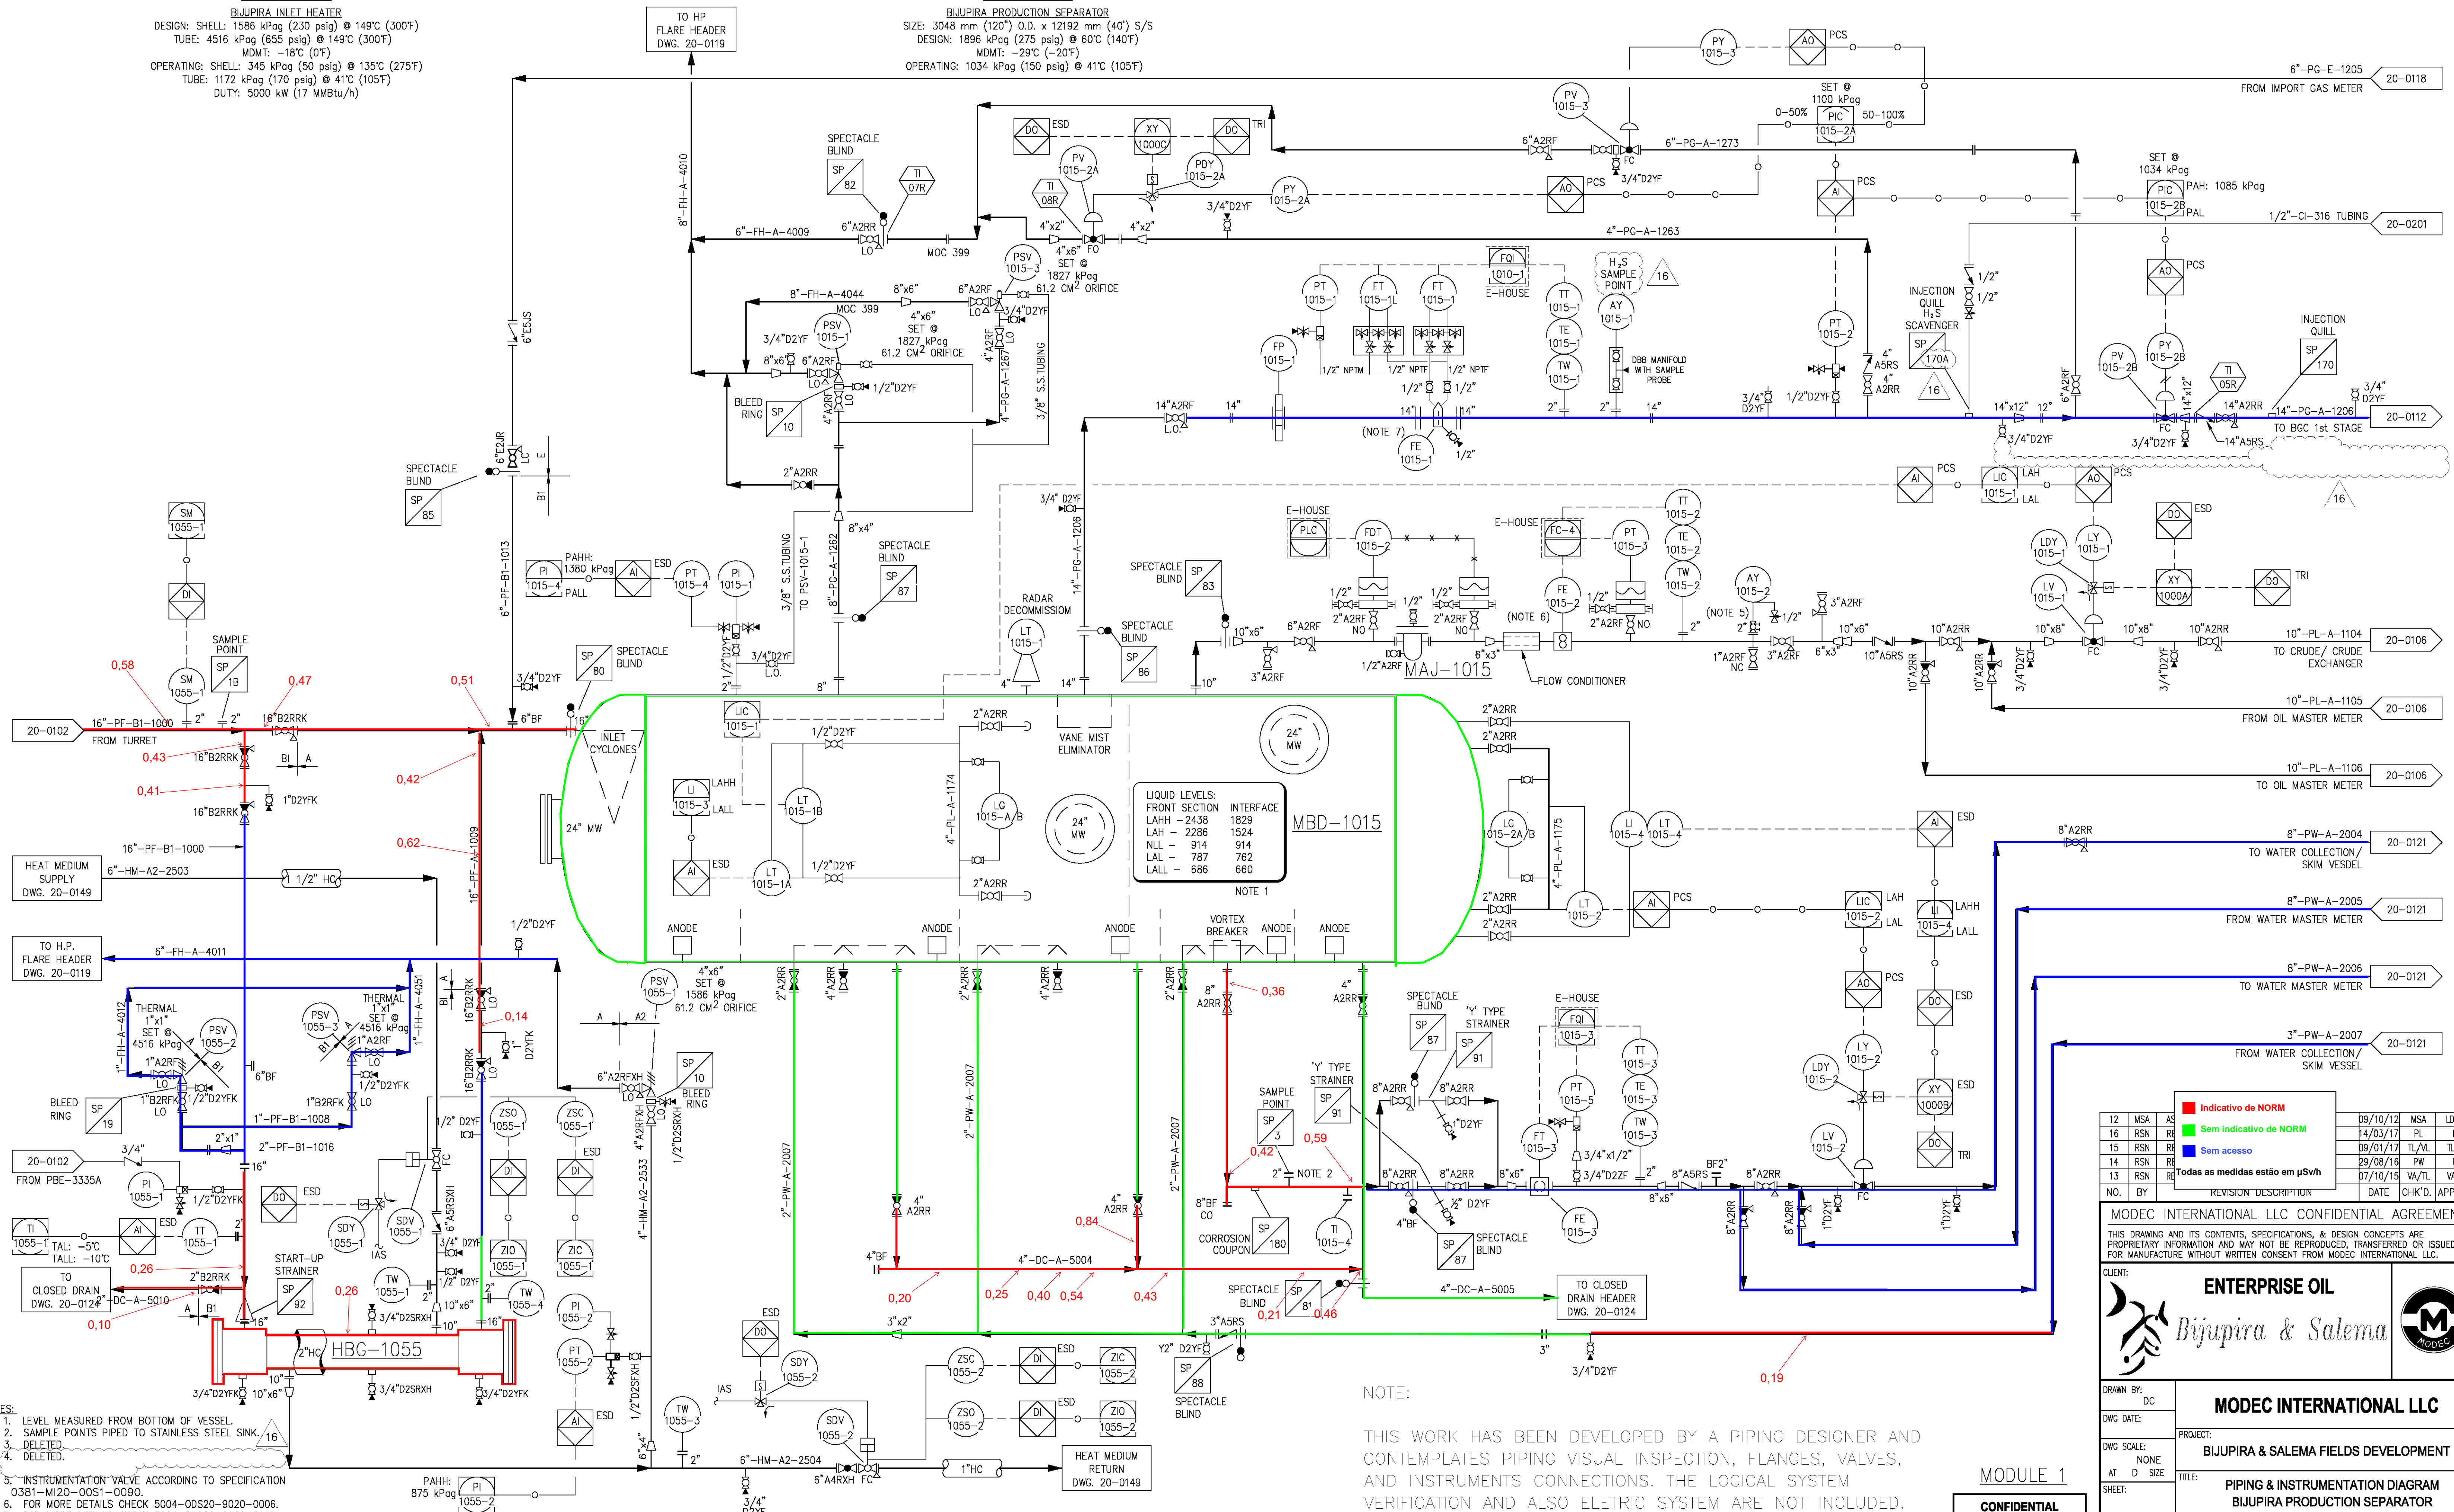

LIQUID LEVELS:

FRONT SECTION	INTERFACE
LAHH - 2438	1829
LAH - 2286	1524
NLL - 914	914
LAL - 787	762
LALL - 686	660

NOTE 1

NOTE:  
 THIS WORK HAS BEEN DEVELOPED BY A PIPING DESIGNER AND CONTEMPLATES PIPING VISUAL INSPECTION, FLANGES, VALVES, AND INSTRUMENTS CONNECTIONS. THE LOGICAL SYSTEM VERIFICATION AND ALSO ELETIC SYSTEM ARE NOT INCLUDED.

12	MSA	AS		D9/10/12	MSA	LD/RD
16	RSN	RE		14/03/17	PL	PL
15	RSN	RE		D9/01/17	TL/ML	TL/ML
14	RSN	RE		29/08/16	PW	PW
13	RSN	RE		D7/10/15	VA/TL	VA/TL

NO. BY REVISION DESCRIPTION DATE CHK'D. APPV'D.

MODEC INTERNATIONAL LLC CONFIDENTIAL AGREEMENT  
 THIS DRAWING AND ITS CONTENTS, SPECIFICATIONS, & DESIGN CONCEPTS ARE PROPRIETARY INFORMATION AND MAY NOT BE REPRODUCED, TRANSFERRED OR ISSUED FOR MANUFACTURE WITHOUT WRITTEN CONSENT FROM MODEC INTERNATIONAL LLC.

CLIENT: **ENTERPRISE OIL**  
*Bijupira & Salema*

**MODEC INTERNATIONAL LLC**


DRAWN BY: DC  
 DWG DATE:  
 DWG SCALE: NONE  
 SHEET: AT D SIZE  
 PROJECT: BIJUPIRA & SALEMA FIELDS DEVELOPMENT  
 TITLE: PIPING & INSTRUMENTATION DIAGRAM BIJUPIRA PRODUCTION SEPARATOR

- NOTES:
- LEVEL MEASURED FROM BOTTOM OF VESSEL.
  - SAMPLE POINTS PIPED TO STAINLESS STEEL SINK.
  - DELETED.
  - DELETED.
  - INSTRUMENTATION VALVE ACCORDING TO SPECIFICATION 03B1-MI20-00S1-0090.
  - FOR MORE DETAILS CHECK 5004-0DS20-9020-0006.
  - FOR MORE DETAILS CHECK 5004-0DS20-9020-0010.
  - FOR MORE DETAILS CHECK 5004-0DS20-9020-0018.

MODULE 1  
 CONFIDENTIAL  
 PROPRIETARY INFORMATION

**HGB-1060**  
 TEST INLET HEATER  
 DESIGN: SHELL 1586 kPag (230 psig) @ 149°C (300°F)  
 TUBE 4516 kPag (655 psig) @ 149°C (300°F)  
 MDMT: -18°C (0°F)  
 OPERATING SHELL 345 kPag (50 psig) @ 135°C (275°F)  
 TUBE 1172 kPag (170 psig) @ 41°C (105°F)  
 DUTY: 1937 kW (6.6 MMBtu/h)

**MBD-1020**  
 TEST PRODUCTION SEPARATOR  
 SIZE: 2286 mm (90") O.D. x 8890 mm (29') S/S  
 DESIGN: 1896 kPag (275 psig) @ 60°C (140°F)  
 MDMT: -29°C (-20°F)  
 OPERATING: 1034 kPag (150 psig) @ 41°C (105°F)

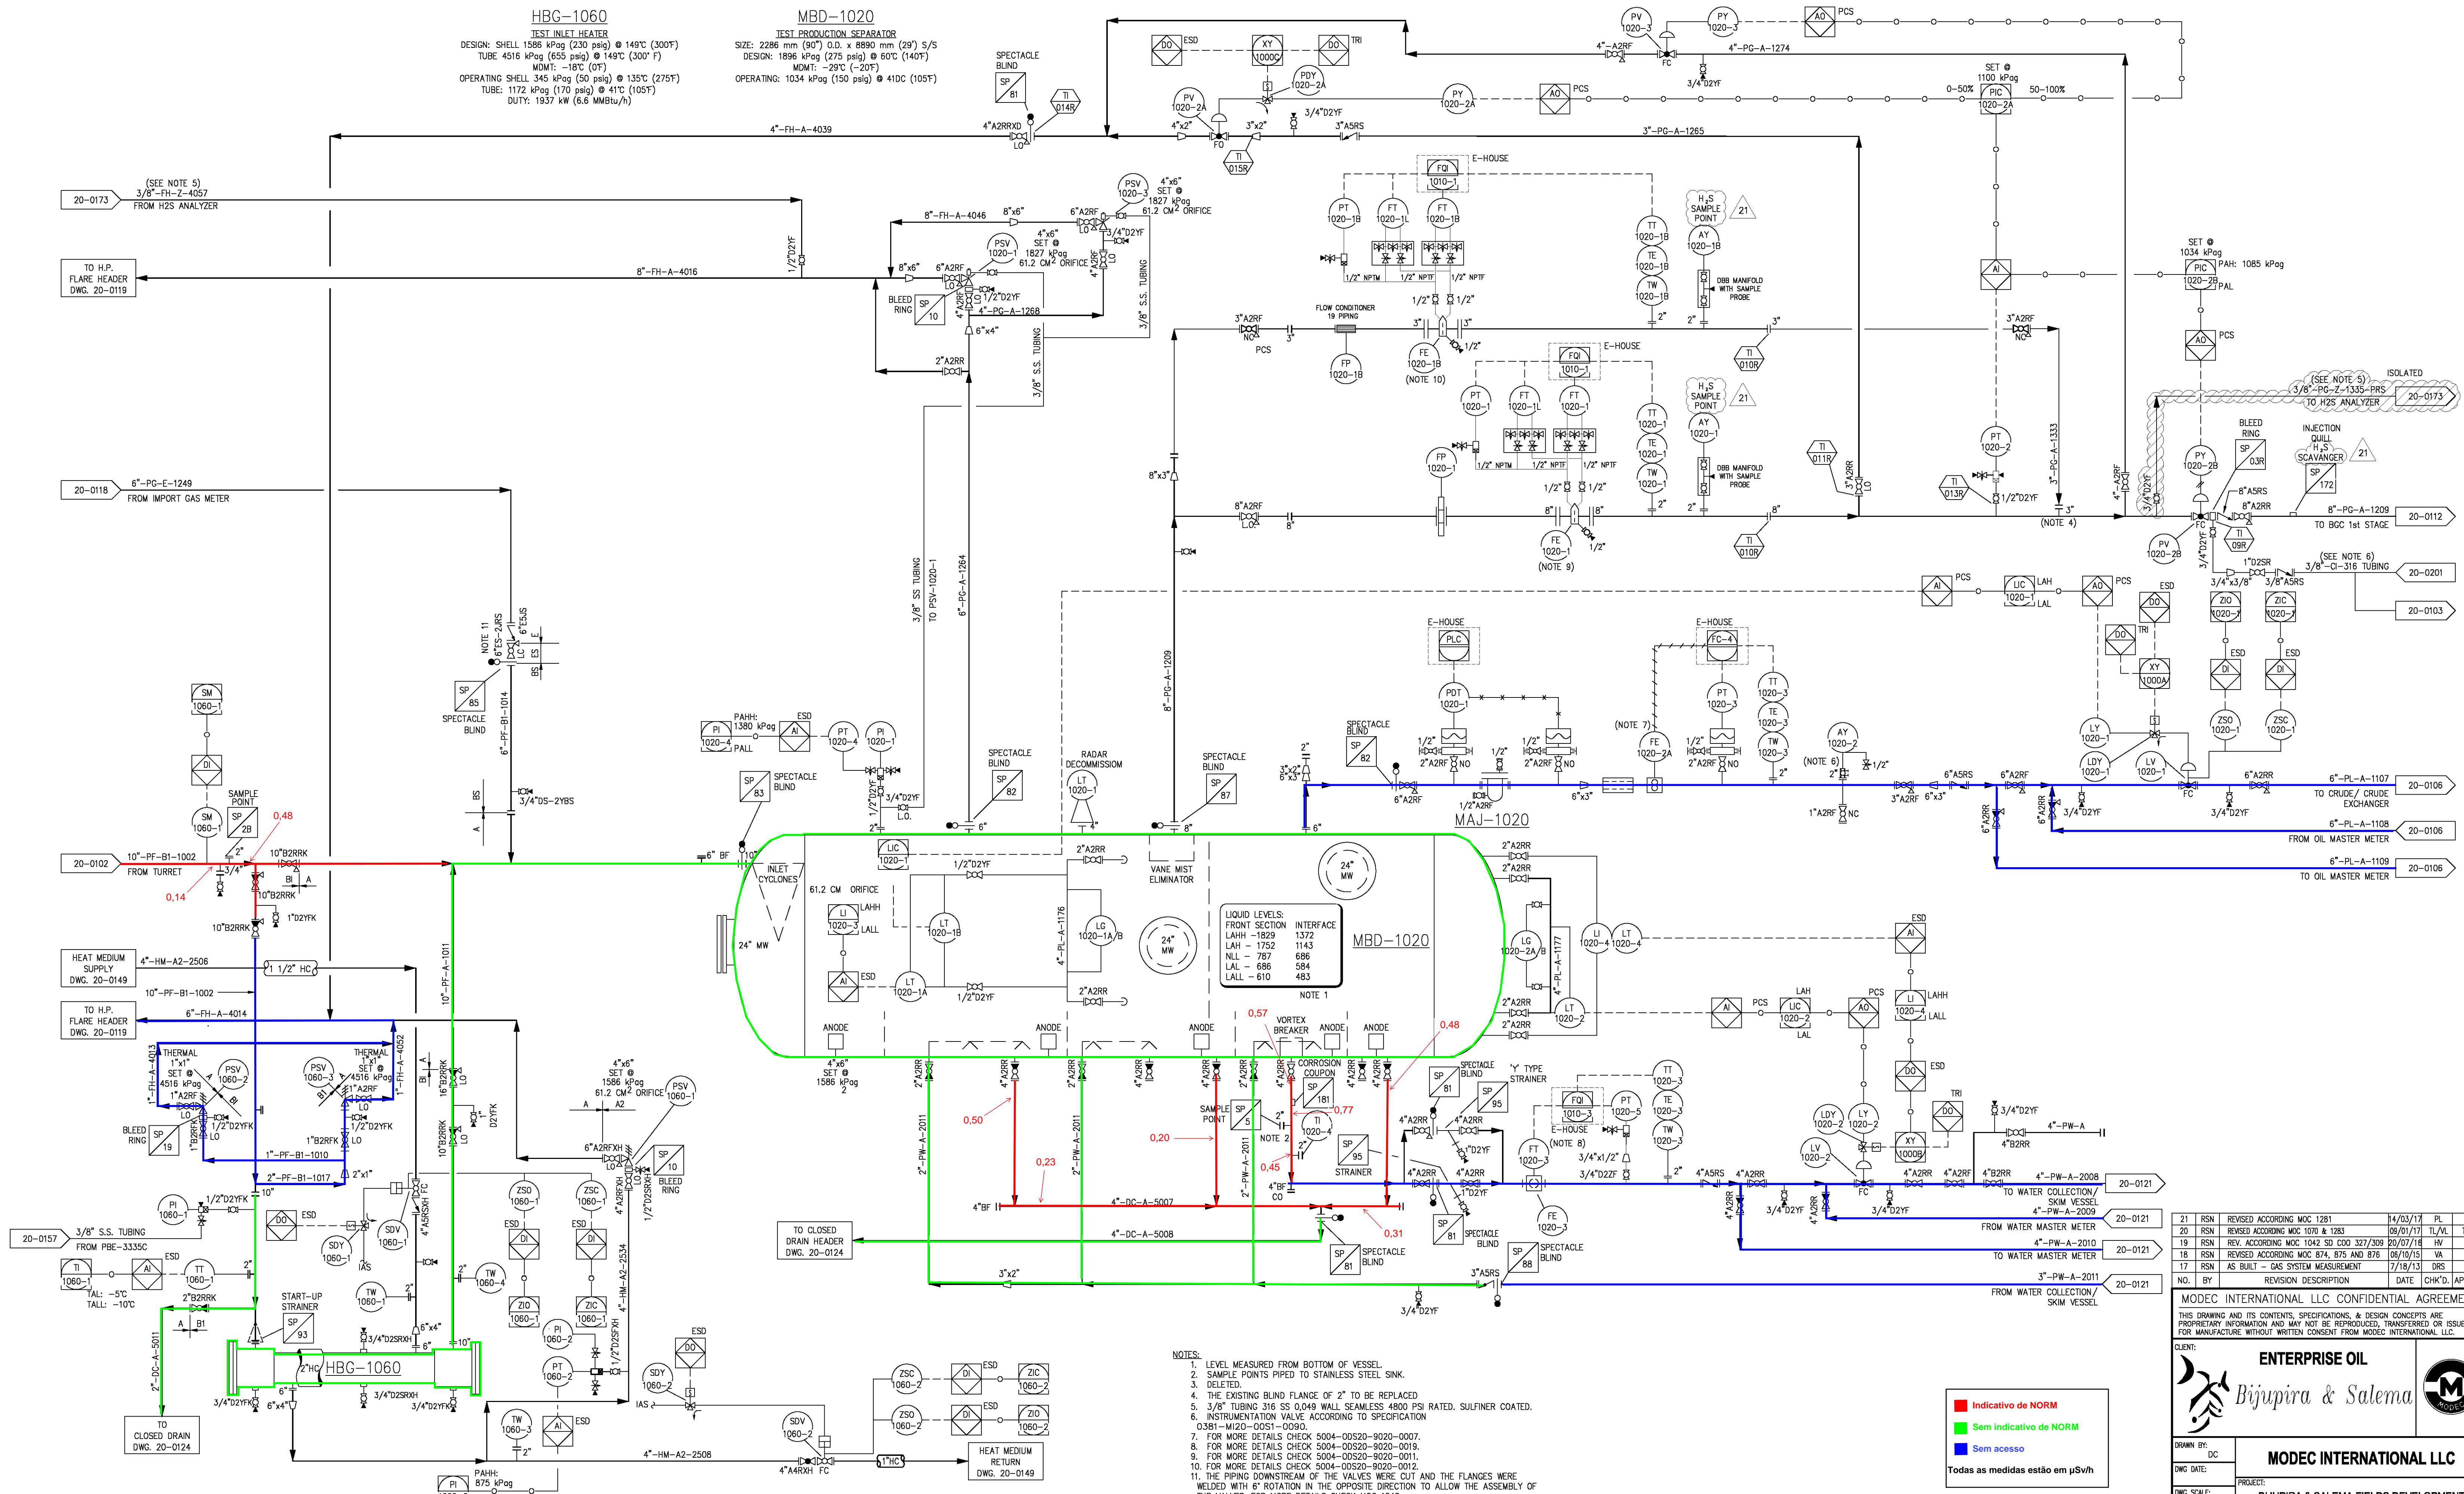

- NOTES:
1. LEVEL MEASURED FROM BOTTOM OF VESSEL.
  2. SAMPLE POINTS PIPED TO STAINLESS STEEL SINK.
  3. DELETED.
  4. THE EXISTING BLIND FLANGE OF 2" TO BE REPLACED.
  5. 3/8" TUBING 316 SS 0.049 WALL SEAMLESS 4800 PSI RATED. SULFINER COATED.
  6. INSTRUMENTATION VALVE ACCORDING TO SPECIFICATION 0381-MI20-00S1-0090.
  7. FOR MORE DETAILS CHECK 5004-0DS20-9020-0007.
  8. FOR MORE DETAILS CHECK 5004-0DS20-9020-0019.
  9. FOR MORE DETAILS CHECK 5004-0DS20-9020-0011.
  10. FOR MORE DETAILS CHECK 5004-0DS20-9020-0012.
  11. THE PIPING DOWNSTREAM OF THE VALVES WERE CUT AND THE FLANGES WERE WELDED WITH 6" ROTATION IN THE OPPOSITE DIRECTION TO ALLOW THE ASSEMBLY OF THE VALVES. FOR MORE DETAILS CHECK MOC 1042.

Indicativo de NORM  
 Sem indicativo de NORM  
 Sem acesso  
 Todas as medidas estão em µSv/h

21	RSN	REVISED ACCORDING MOC 1281	14/03/17	PL	PL
20	RSN	REVISED ACCORDING MOC 1070 & 1283	09/01/17	TL/VL	TL/VL
19	RSN	REV. ACCORDING MOC 1042 SD C00 327/309	20/07/16	HW	DE
18	RSN	REVISED ACCORDING MOC 874, 875 AND 876	06/10/15	VA	VA
17	RSN	AS BUILT - GAS SYSTEM MEASUREMENT	7/18/13	DRS	DRS

MODEC INTERNATIONAL LLC CONFIDENTIAL AGREEMENT  
 THIS DRAWING AND ITS CONTENTS, SPECIFICATIONS, & DESIGN CONCEPTS ARE PROPRIETARY INFORMATION AND MAY NOT BE REPRODUCED, TRANSFERRED OR ISSUED FOR MANUFACTURE WITHOUT WRITTEN CONSENT FROM MODEC INTERNATIONAL LLC.

CLIENT: **ENTERPRISE OIL**  
**Bijupira & Salema**

DRAWN BY: DC  
 DWG DATE:  
 DWG SCALE: NONE  
 AT D SIZE  
 SHEET:  
**MODEC INTERNATIONAL LLC**  
 PROJECT: BIJUPIRA & SALEMA FIELDS DEVELOPMENT  
 TITLE: PIPING & INSTRUMENTATION DIAGRAM  
 TEST PRODUCTION SEPARATOR  
 CAD FILE: 01-20-0105  
 DWG NO: 1058-AE-20-90-20-0105  
 REV. 1

MODULE 1

CONFIDENTIAL  
 PROPRIETARY INFORMATION

HGB-1150(OUT OF OPERATION)


HGB-1110A/B

HGB-1115(OUT OF OPERATION)

**SALES OIL COOLER**  
 DESIGN: HOT 1035 kPag (150 psig) @ 93°C (200°F)  
 COLD 1035 kPag (150 psig) @ 93°C (200°F)  
 OPERATING: HOT 20 kPag (3 psig) @ 46°C (115°F) IN, 38°C (100°F) OUT  
 COLD 655 kPag (95 psig) @ 38°C (100°F) OUT, 30°C (86°F) IN  
 DUTY: 1850 kW (6.3 MMBtu/h)

**CRUDE/CRUDE EXCHANGERS**  
 DESIGN: HOT SIDE: 1379 kPag (200 psig) @ 93°C (200°F)  
 COLD SIDE: 1379 kPag (200 psig) @ 93°C (200°F)  
 OPERATING: HOT SIDE: 70 kPag (10 psig) @ 66°C (150°F)  
 COLD SIDE: 552 kPag (80 psig) @ 56°C (133°F)  
 DUTY: 3829 kW (13 MMBtu/h)

**CRUDE HEATER**  
 DESIGN: HOT SIDE: 1380 kPag (200 psig) @ 149°C (300°F)  
 COLD SIDE: 1380 kPag (200 psig) @ 149°C (300°F)  
 OPERATING: HOT SIDE: 345 kPag (50 psig) @ 135°C (275°F)  
 COLD SIDE: 517 kPag (75 psig) @ 66°C (150°F)  
 DUTY: 2804 kW (10 MMBtu/h)

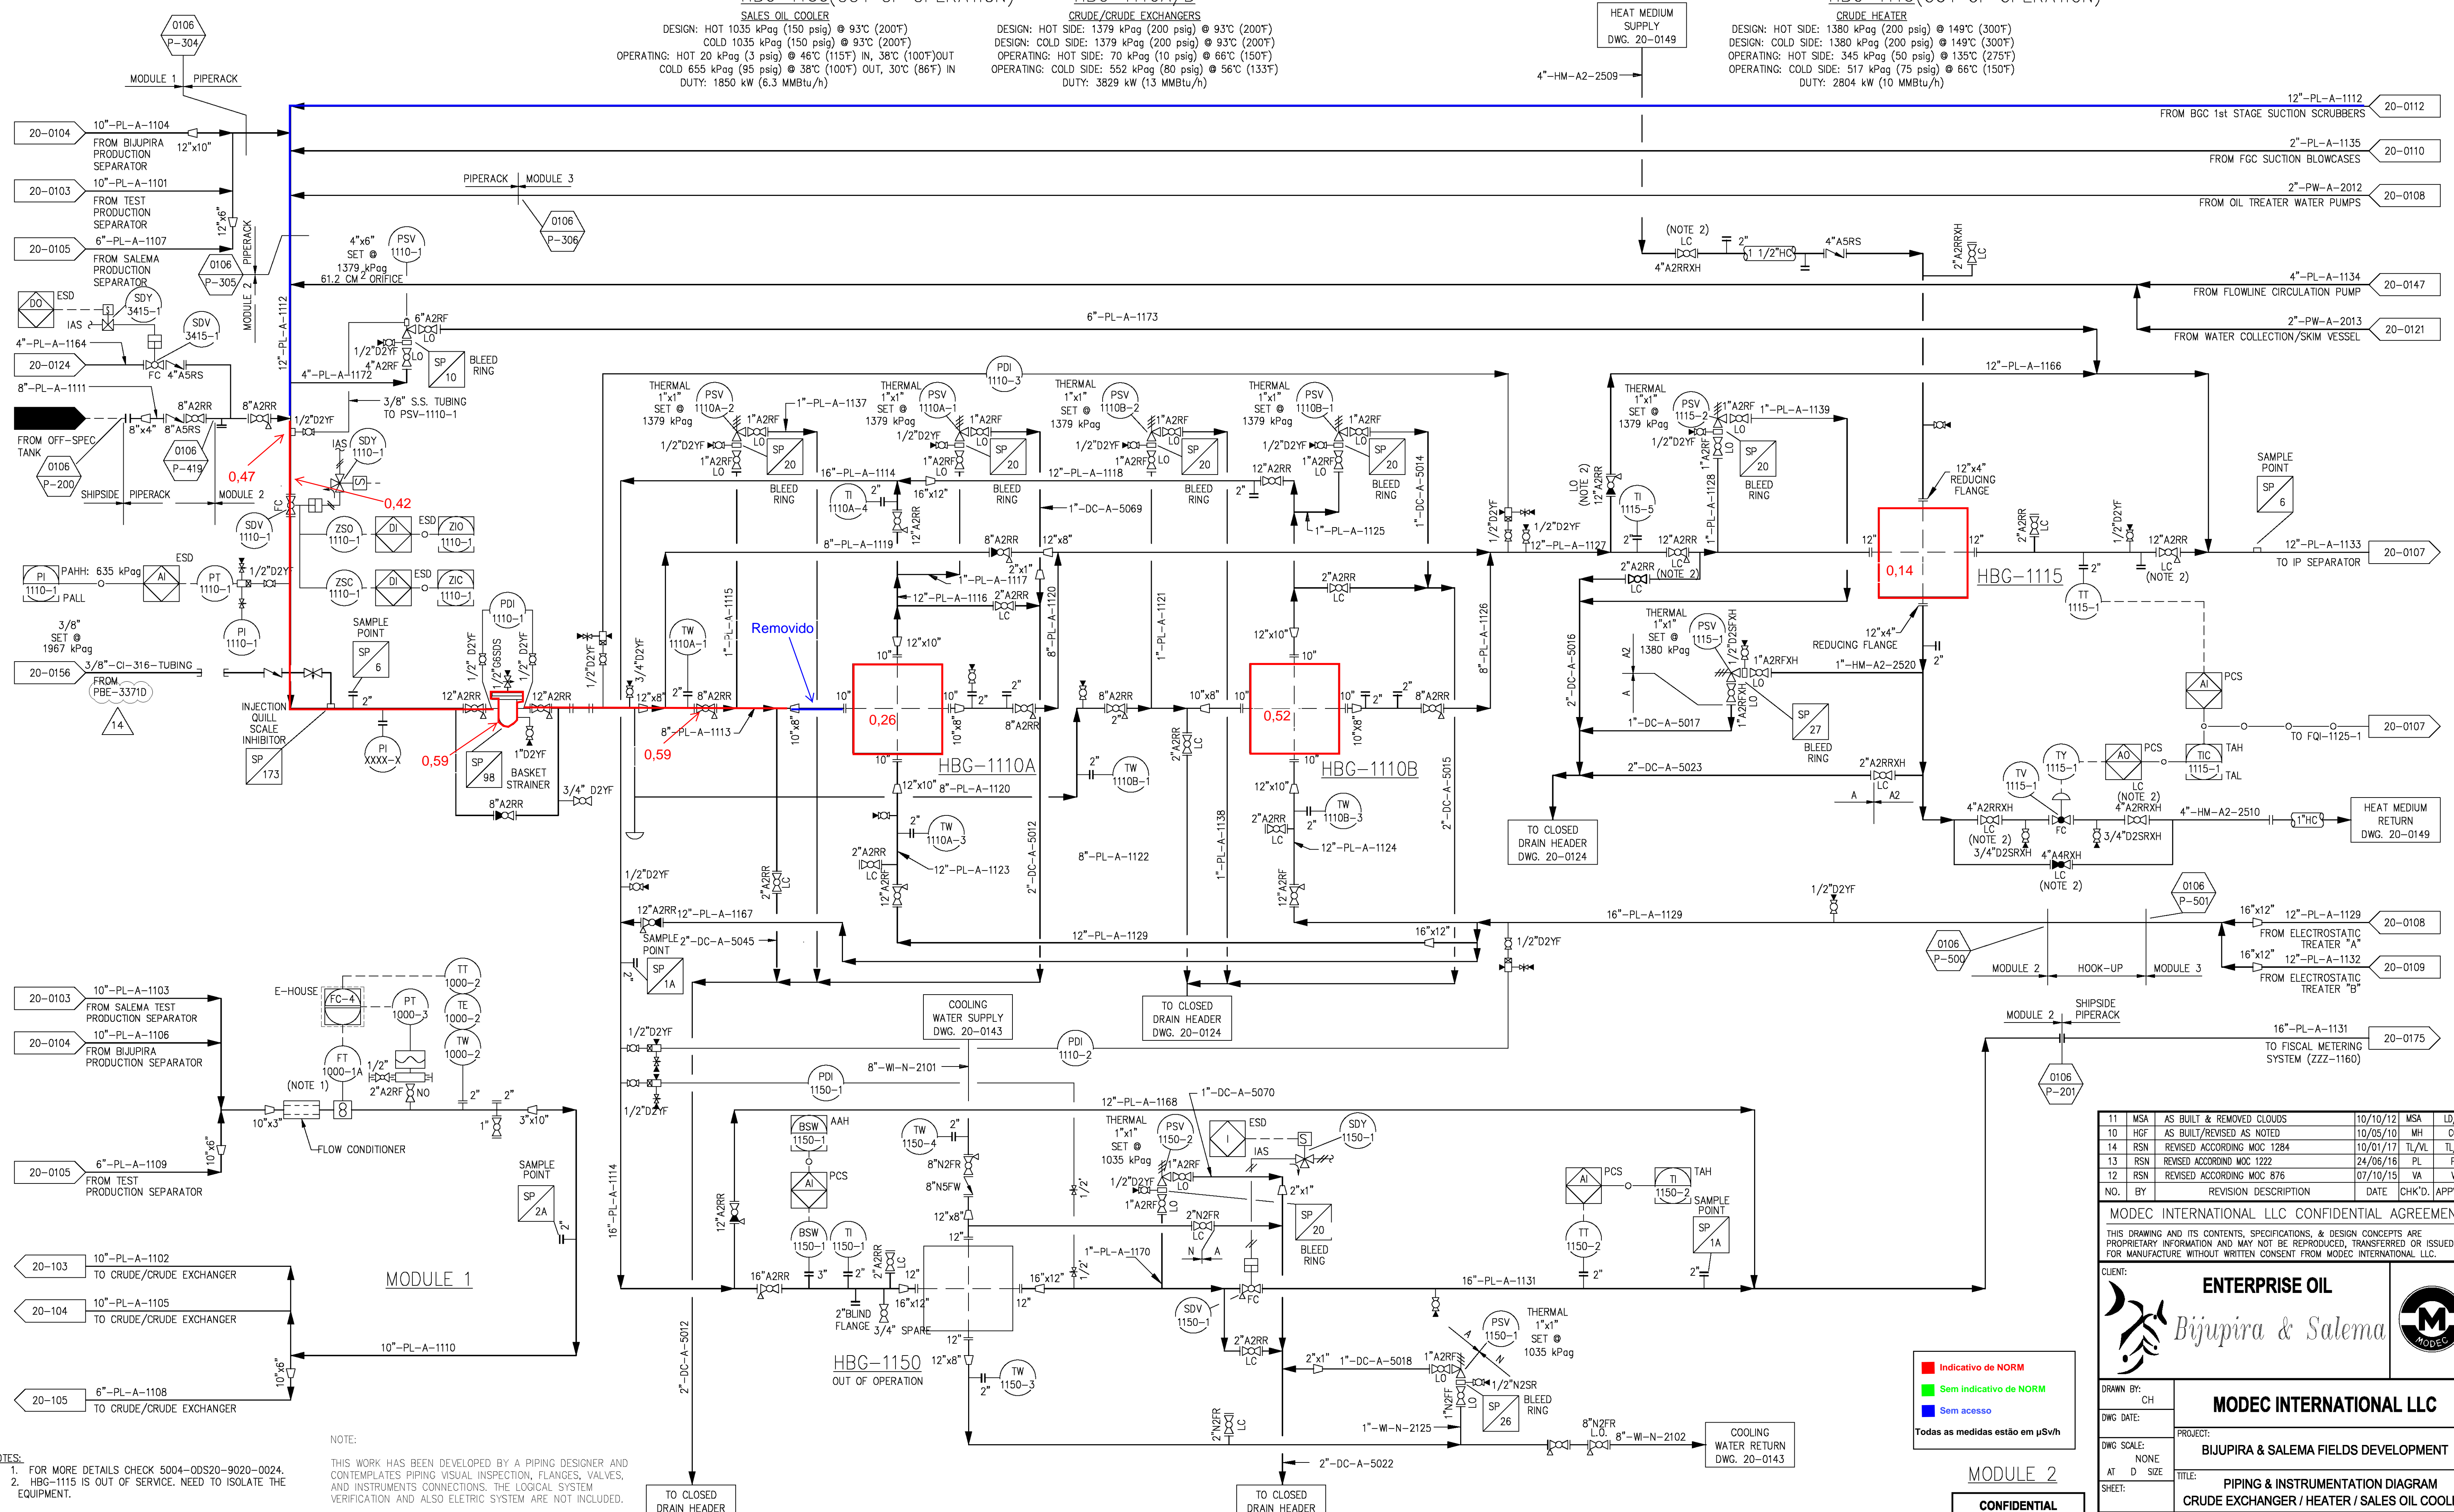

**NOTES:**  
 1. FOR MORE DETAILS CHECK 5004-ODS20-9020-0024.  
 2. HGB-1115 IS OUT OF SERVICE. NEED TO ISOLATE THE EQUIPMENT.

**NOTE:**  
 THIS WORK HAS BEEN DEVELOPED BY A PIPING DESIGNER AND CONTEMPLATES PIPING VISUAL INSPECTION, FLANGES, VALVES, AND INSTRUMENT CONNECTIONS. THE LOGICAL SYSTEM VERIFICATION AND ALSO ELETRIC SYSTEM ARE NOT INCLUDED.

**Indicativo de NORM**  
**Sem indicativo de NORM**  
**Sem acesso**  
 Todas as medidas estão em µSv/h

11	MSA	AS BUILT & REMOVED CLOUDS	10/10/12	MSA	LD/RD
10	HGF	AS BUILT/REVISED AS NOTED	10/05/10	MH	CCP
14	RSN	REVISED ACCORDING MOC 1284	10/01/17	TL/VL	TL/VL
13	RSN	REVISED ACCORDING MOC 1222	24/06/16	PL	PL
12	RSN	REVISED ACCORDING MOC 876	07/10/15	VA	VA
NO.	BY	REVISION DESCRIPTION	DATE	CHK'D.	APP'V'D.

**MODEC INTERNATIONAL LLC CONFIDENTIAL AGREEMENT**  
 THIS DRAWING AND ITS CONTENTS, SPECIFICATIONS, & DESIGN CONCEPTS ARE PROPRIETARY INFORMATION AND MAY NOT BE REPRODUCED, TRANSFERRED OR ISSUED FOR MANUFACTURE WITHOUT WRITTEN CONSENT FROM MODEC INTERNATIONAL LLC.

CLIENT: **ENTERPRISE OIL**  
**Bijupira & Salema**


**MODEC INTERNATIONAL LLC**

DRAWN BY: CH  
 DWG DATE:  
 DWG SCALE: NONE  
 AT D SIZE  
 SHEET:

PROJECT: **BIJUPIRA & SALEMA FIELDS DEVELOPMENT**  
 TITLE: **PIPING & INSTRUMENTATION DIAGRAM**  
**CRUDE EXCHANGER / HEATER / SALES OIL COOLER**

CAD FILE: 1058-AE-20-90-20-0106  
 DWG NO: 1058-AE-20-90-20-0106  
 REV: 01-20-0106

**CONFIDENTIAL**  
**PROPRIETARY INFORMATION**

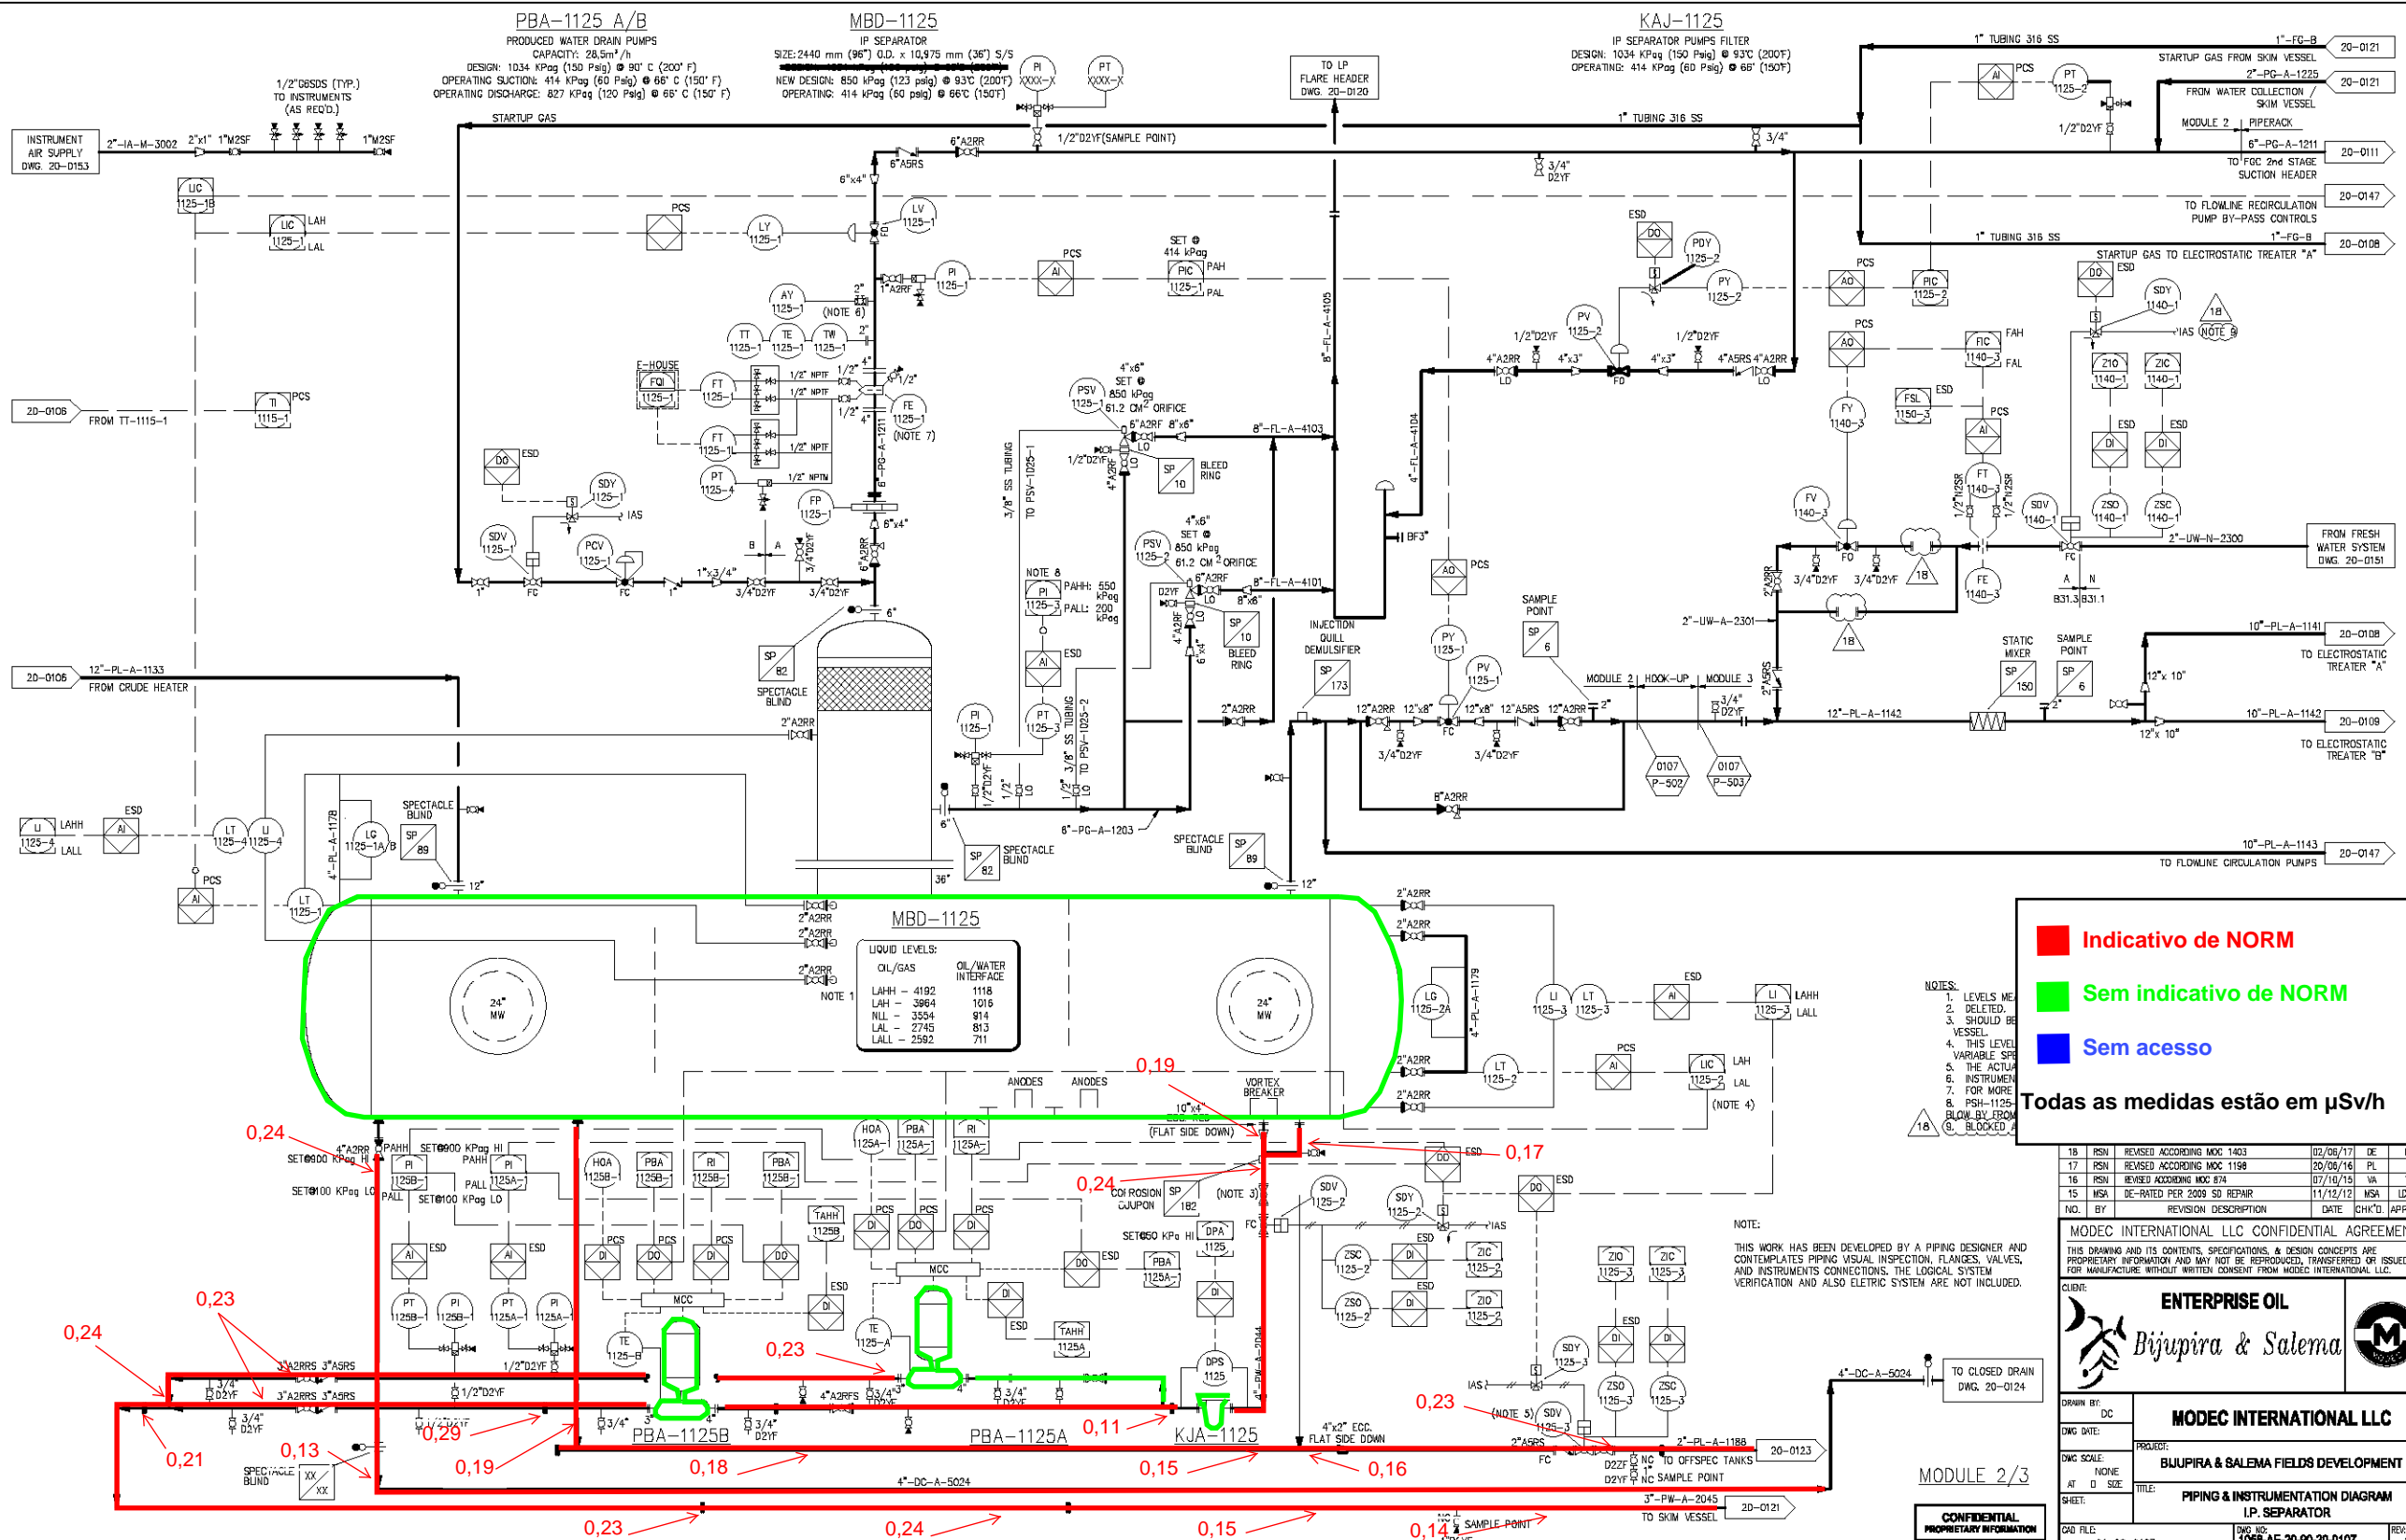

**Indicativo de NORM**

**Sem indicativo de NORM**

**Sem acesso**

Todas as medidas estão em  $\mu\text{Sv/h}$

- NOTES:
- LEVELS MEASUREMENTS SHOULD BE TAKEN AT THE POINTS INDICATED.
  - DELETED.
  - SHOULD BE TAKEN AT THE POINTS INDICATED.
  - THIS LEVEL VARIABLE SPECIFICATION.
  - THE ACTUAL INSTRUMENTATION FOR MORE INFORMATION.
  - PSH-1125 BLOW BY ESD.
  - BLOCKED.

NO.	BY	REVISION DESCRIPTION	DATE	CHK'D.	APPR'D.
18	RSN	REVISED ACCORDING MOC 1403	02/06/17	DE	DE
17	RSN	REVISED ACCORDING MOC 1198	20/06/16	PL	PL
16	RSN	REVISED ACCORDING MOC 874	07/10/15	VA	VA
15	MSA	DE-RATED PER 2009 SD REPAIR	11/12/12	MSA	LD/BD

MODEC INTERNATIONAL LLC CONFIDENTIAL AGREEMENT

THIS DRAWING AND ITS CONTENTS, SPECIFICATIONS, & DESIGN CONCEPTS ARE PROPRIETARY INFORMATION AND MAY NOT BE REPRODUCED, TRANSFERRED OR ISSUED FOR MANUFACTURE WITHOUT WRITTEN CONSENT FROM MODEC INTERNATIONAL LLC.

CLIENT: **ENTERPRISE OIL**  
*Bijupira & Salema*

DRAWN BY: DC  
DWG DATE: 20/06/16  
DWG SCALE: NONE  
AT D SIZE: TITLE: PIPING & INSTRUMENTATION DIAGRAM I.P. SEPARATOR

PROJECT: **MODEC INTERNATIONAL LLC**  
**BUJUPIRA & SALEMA FIELDS DEVELOPMENT**

CONFIDENTIAL PROPRIETARY INFORMATION

DWG NO: 1088-AE-20-90-20-0107  
REV: 01-20-0107

NOTE: THIS WORK HAS BEEN DEVELOPED BY A PIPING DESIGNER AND CONTEMPLATES PIPING VISUAL INSPECTION, FLANGES, VALVES, AND INSTRUMENT CONNECTIONS. THE LOGICAL SYSTEM VERIFICATION AND ALSO ELECTRIC SYSTEM ARE NOT INCLUDED.